

**MISSISSIPPI DEPARTMENT OF NATURAL RESOURCES**  
**Bureau of Land and Water Resources**  
 Southport Mall  
 P.O. Box 10631  
 Jackson, Mississippi 39209  
**WATER WELL DRILLERS LOG**

K 2188  
JACKSON  
1-25-85

1-25-85 19 Coast Water Well Sew. Jackson  
 date well completed firm name county well located

LANDOWNER: Don Ireland  
14513 Low Point Road  
Ocean Springs, Miss.  
 (mailing address) 37564  
 WELL LOCATION:  
 sec. 5 T. 6 R. 2  
2 miles NW of Vandaleau  
 (distance) (direction) (nearest town)

description of formations encountered	from	to
<u>Top soil</u>	<u>0</u>	<u>3'</u>
<u>Red Clay</u>	<u>3</u>	<u>10'</u>
<u>Red Clay</u>	<u>10'</u>	<u>40'</u>
<u>Sand &amp; Red Druml</u>	<u>40'</u>	<u>120'</u>
<u>Blue Clay</u>	<u>120'</u>	<u>250'</u>
<u>Sand Cause</u>		

WELL PURPOSE:  
 (home, irrigation, municipal, industrial)

WELL COMPLETION DATA:  
 (1) diameter (inches) 2"  
 (2) total depth (feet) 275'  
 (3) static water level (feet) 60 (below/above top of ground)  
 (4) casing PVC 265'  
 (material) (depth)  
2" If telescope see back.  
 (size)  
 (5) screen 10' 265'  
 (length) (depth to top)  
2" PVC  
 (size) (material)  
 (6) pump 1/2 HP 8 1/2  
 (HP) (yield gpm)  
Electric  
 (type power)  
 (7) electric log No  
 (yes or no)  
 (organization running log)

(8) how well bottom plugged  
Back wash valve


DRILLERS REMARKS:

**RECEIVED**  
 APR 2 - 1985

Department of Natural Resources  
 Bureau of Land & Water Resources

If well telescopes please sketch and show depths.

GROUND LEVEL

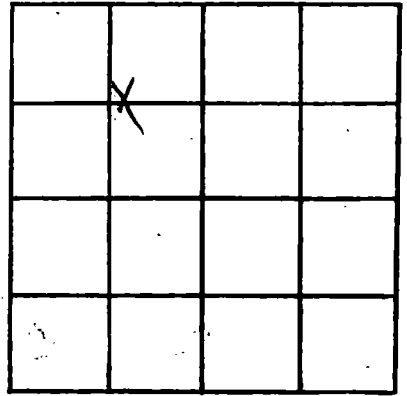

SECTION 5

Please indicate well location X.

ADDITIONAL INFORMATION

Lined area for additional information.

If more than one screen, show locations of each on sketch.