

MISSISSIPPI DEPARTMENT OF NATURAL RESOURCES

Bureau of Land and Water Resources

Southport Mall

P.O. Box 10631

Jackson, Mississippi 39209

WATER WELL DRILLERS LOG

JACKSON
K 2190

3-28-85
date well completed

Coast Water Well Sew. Jackson
firm name county well located

LANDOWNER: Robert Mahnette

2204 Mahnette Rd

Vincennes, Miss.
(mailing address) 39164

WELL LOCATION:

sec. 12 T. 6 N. R. 7 E. S. 1 W.
2 1/2 miles E of VANCELAUE
(distance) (direction) (nearest town)

WELL PURPOSE: Home
(home, irrigation, municipal, industrial)

WELL COMPLETION DATA:

- (1) diameter (inches) 2"
- (2) total depth (feet) 150'
- (3) static water level (feet) 15' below top of ground
- (4) casing PVC, 140' (material) (depth)
- (5) screen 2" (size) If telescope see back: 10' (length), 140' (depth to top)
- (6) pump (HP) (yield gpm)
- (7) electric log No (yes or no)
- (organization running log)

(8) how well bottom plugged Backwash Valve

DRILLERS REMARKS:


description of formations encountered	from	to
Top soil	0	2'
Red Clay	2	18'
Sand (Red Base)	18'	63'
Gray Clay	63'	85'
Coarse Sand	85'	147'
Blue Clay	147'	150'

RECEIVED
JUL 10 1985

Department of Natural Resources
Bureau of Land & Water Resources

If well telescopes please sketch and show depths.

GROUND LEVEL

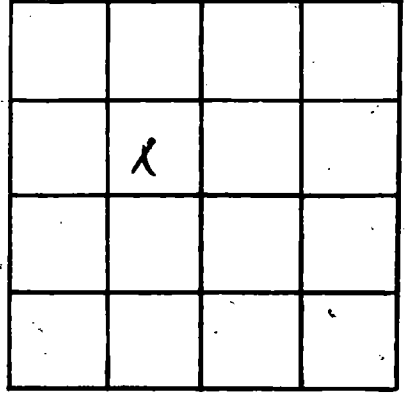

SECTION 12

Please indicate well location X.

ADDITIONAL INFORMATION

If more than one screen,
show locations of each on sketch.