

MISSISSIPPI DEPARTMENT OF NATURAL RESOURCES

Bureau of Land and Water Resources

Southport Mall

P.O. Box 10631

Jackson, Mississippi 39209

WATER WELL DRILLERS LOG

K 2191
JACKSON
3-29-85

3-29-85

19 Dunlop well service Jackson
date well completed firm name county well located

LANDOWNER Larry McCoy
1613 POTICAW Rd.
Vandeventer, MS 39564
(mailing address)

WELL LOCATION:
sec 13 T 6 N R 7 E
4 miles W of Vandeventer
(distance) (direction) (nearest town)

WELL PURPOSE:
(home, irrigation, municipal, industrial)

WELL COMPLETION DATA:

- (1) diameter (inches) 4"
- (2) total depth (feet) 220'
- (3) static water level (feet) 80' ^{below} _{above} top of ground.
- (4) casing PVC, 210'
(material) (depth)
yes If telescope see back.
(no)
- (5) screen 10', 210'
(length) (depth to top)
2", PVC
(size) (material)
- (6) pump 1/2, 20
(HP) (yield gpm)
Electric
(type power)
- (7) electric log no
(yes or no)
(organization running log)
- (8) how well bottom plugged PVC
Ballhead

description of formations encountered	from	to
<u>Sand Clay</u>	<u>0</u>	<u>10</u>
<u>Gravel</u>	<u>10</u>	<u>20</u>
<u>Sand</u>	<u>20</u>	<u>30</u>
<u>Clay</u>	<u>30</u>	<u>50</u>
<u>Clay</u>	<u>50</u>	<u>90</u>
<u>Sand</u>	<u>90</u>	<u>130</u>
<u>Clay + streaks Sand</u>	<u>130</u>	<u>160</u>
<u>Fine to med Sand</u>	<u>160</u>	<u>220</u>


RECEIVED
SEP 17 1985

Department of Natural Resources
Bureau of Land & Water Resources

DRILLERS REMARKS:

If well telescopes please sketch and show depths.

GROUND LEVEL

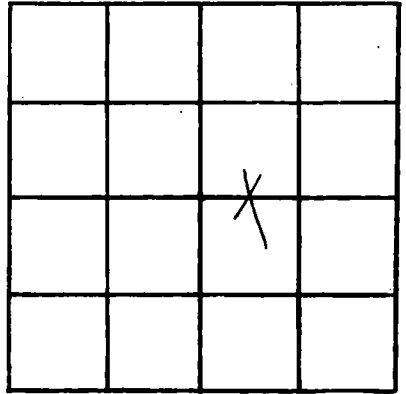

SECTION 13

Please indicate well location X.

ADDITIONAL INFORMATION

If more than one screen,
show locations of each on sketch.