

MISSISSIPPI DEPARTMENT OF NATURAL RESOURCES
 Bureau of Land and Water Resources
 Southport Mall
 P.O. Box 10631
 Jackson, Mississippi 39209
WATER WELL DRILLERS LOG

Jackson
 K 2193
 4-16-85

L

4-16-1985 date well completed
 Const Water Well Sew. firm name
 Jackson county well located

LANDOWNER: Jerrin Cole
Vanderburg, Miss.
 (mailing address) 39564

WELL LOCATION:
 sec. 11 T. 6 S. R. 7 E
2 miles (distance) EAST (direction) of VANDERBURG (nearest town)

WELL PURPOSE: Home
 (home, irrigation, municipal, industrial)

- WELL COMPLETION DATA:
- (1) diameter (inches) 2"
 - (2) total depth (feet) 260
 - (3) static water level (feet) 90' below top of ground
 - (4) casing PVC, 250' (material), (depth)
2" (size) if telescope see back.
 - (5) screen 10 (length), 250' (depth to top)
2" (size), PVC (material)
 - (6) pump 2 h.p. (HP), 12 (yield gpm)
Chlor. (type power)
 - (7) electric log No (yes or no)
 (organization running log)
 - (8) how well bottom plugged Back Wash Valve

description of formations encountered	from	to
Red Clay	0	15'
Coarse sand	15'	40'
Gray Clay	40'	85'
Red Sand (strip Clay)	85'	145'
Blue Clay	145'	235'
Blue Clay (strip sand)	235'	247'
Coarse white sand	247'	260'


RECEIVED
 JUL 11 1985

Department of Natural Resources
 Bureau of Land & Water Resources

DRILLERS REMARKS:

If well telescopes please sketch and show depths.

GROUND LEVEL

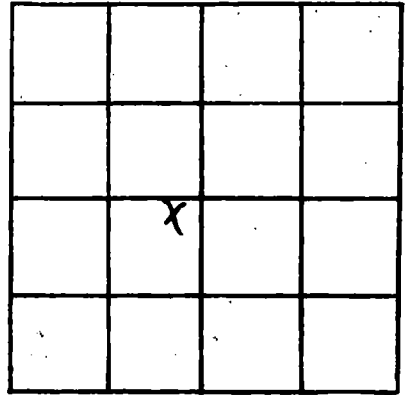

SECTION 11

Please indicate well location X.

ADDITIONAL INFORMATION

If more than one screen,
show locations of each on sketch.