

Jackson
 R 2196
 4-20-85

MISSISSIPPI
 BOARD OF WATER COMMISSIONERS
 416 North State Street
 Jackson, Mississippi 39201

L

WATER WELL DRILLERS LOG

4-20-1985 Fleice Drilling Jackson
 date well completed firm name county well located

LANDOWNER: James M. Millian

description of formations encountered from to

Vandœuvre, Ms
 (mailing address)

Top soil 0 10
Clay 10 20
good sand 20 46

WELL LOCATION:

sec. 12 T 6 N R 7 E 7
 4 miles South of Vandœuvre
 (distance) (direction) (nearest town)

WELL PURPOSE:

home irrigation, municipal, industrial

WELL COMPLETION DATA:

- (1) diameter (inches) 2"
- (2) total depth (feet) 46'
- (3) static water level (feet) 30' below above top of ground.
- (4) casing plastic, 36'
 (material) (depth)
0 If telescope see back.
 (size)
- (5) screen 10', 46'
 (length) (depth to top)
006, plastic
 (size) (material)
- (6) pump 1 10
 (HP) (yield gpm)
electric
 (type power)
- (7) electric log (yes or no)
 (organization running log)
- (8) how well bottom plugged BW


DRILLERS REMARKS:

RECEIVED

JUL 28 1985

If well telescopes please sketch and show depths.

GROUND LEVEL

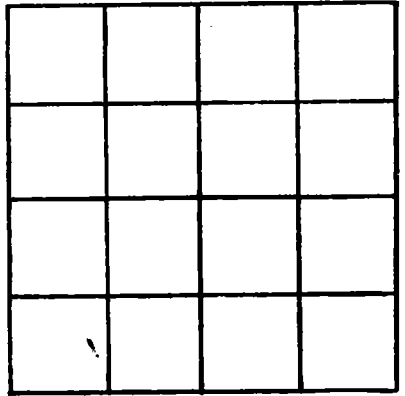

SECTION _____

Please indicate well location X.

ADDITIONAL INFORMATION

If more than one screen, show locations of each on sketch.