

MISSISSIPPI DEPARTMENT OF NATURAL RESOURCES

Bureau of Land and Water Resources

Southport Mall

P.O. Box 10631

Jackson, Mississippi 39209

WATER WELL DRILLERS LOG

Jackson
K 2199
6-5-85

L

6-5-85
date well completed

Cross Water Well Sew.
firm name

Jackson
county well located

LANDOWNER:

Jack Hoover
112 Shifwood Rd.
Pascagoula, Miss.
(mailing address) 39267

description of formations encountered

from to

Top soil	0	1'
Red med. sand	1'	120'
Blue Clay	120'	205'
Gray coarse sand	205'	310'
Blue Clay	310'	337'
Gray fine sand	337'	393'
Blue Clay	393'	455'
Gray coarse sand	455'	478'
Blue Clay	478'	480'

WELL LOCATION:

sec 27 T 6 S R 7 E
3 miles SE of VAN CLEAVE
(distance) (direction) (nearest town)

WELL PURPOSE:

Home (home, irrigation, municipal, industrial)

WELL COMPLETION DATA:

- diameter (inches) 2"
- total depth (feet) 480'
- static water level (feet) 38' below top of ground.
- casing PVC 470' (material) (depth)
2" (size) if telescope see back.
- screen 10' 470' (length) (depth to top)
2" (size) PVC (material)
- pump 1 hp (HP) 11 (yield gpm)
Electric (type power)
- electric log No. (yes or no)
(organization running log)

(8) how well bottom plugged Backwash Valve


DRILLERS REMARKS:

RECEIVED
JUL 11 1985

Department of Natural Resources
Bureau of Land & Water Resources

If well telescopes please sketch and show depths.

GROUND LEVEL

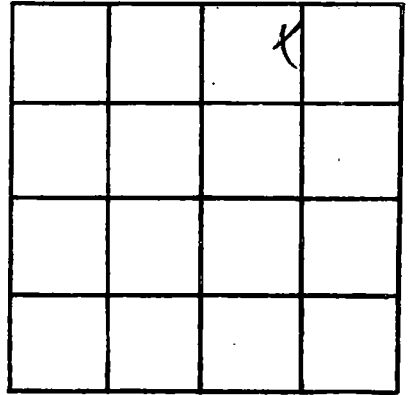

SECTION 27

Please indicate well location X.

ADDITIONAL INFORMATION

If more than one screen,
show locations of each on sketch.