

MISSISSIPPI DEPARTMENT OF NATURAL RESOURCES

Bureau of Land and Water Resources

Southport Mall

P.O. Box 10631

Jackson, Mississippi 39209

WATER WELL DRILLERS LOG

JACKSON  
K 2202

8-26-85 19 Coast & Water Well Sew. Jackson  
 date well completed firm name county well located

LANDOWNER: Lloyd Jones  
P.O. Box 3084  
Vance Ave,  
Miss.  
 (mailing address) 39264

description of formations encountered	from	to
<u>Red Clay</u>	<u>0</u>	<u>15'</u>
<u>Red med. sand</u>	<u>15'</u>	<u>30'</u>
<u>Red Coar. sand</u>	<u>30'</u>	<u>40'</u>
<u>Red Clay</u>	<u>40'</u>	<u>95'</u>
<u>Red Clay &amp; streak med. sand</u>	<u>95'</u>	<u>105'</u>
<u>Red med. sand</u>	<u>105'</u>	<u>135'</u>
<u>Red Clay</u>	<u>135'</u>	<u>138'</u>
<u>(8ft 2" Tail Pipe)</u>		


WELL LOCATION:  
 sec 24 T 6 S R 7 E  
3 miles SE of VANCE AVE  
 (distance) (direction) (nearest town)

WELL PURPOSE: Home  
 (home, irrigation, municipal, industrial)

WELL COMPLETION DATA:

- (1) diameter (inches) 2"
- (2) total depth (feet) 138'
- (3) static water level (feet) 60' <sup>below</sup> <sub>above</sub> top of ground.
- (4) casing PVC, 128'  
 (material) (depth)  
2" if telescope see back.  
 (size)
- (5) screen 10', 128'  
 (length) (depth to top)  
2" PVC  
 (size) (material)
- (6) pump 1 HP, 8  
 (HP) (yield gpm)  
Electric  
 (type power)
- (7) electric log No  
 (yes or no)
- (organization running log)
- (8) how well bottom plugged Back Wash Valve

DRILLERS REMARKS:  
8' 2" Tail Pipe

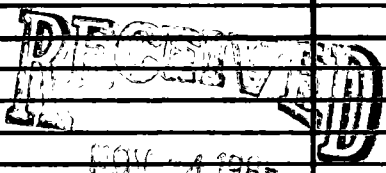

Department of Natural Resources  
 Bureau of Land & Water Resources

