

MISSISSIPPI DEPARTMENT OF NATURAL RESOURCES
Bureau of Land and Water Resources
 Southport Mall
 P.O. Box 10631
 Jackson, Mississippi 39209
WATER WELL DRILLERS LOG

Jackson
K2903

8-30-85 19 Coast water well Jackson
 date well completed firm name county well located

LANDOWNER: Henry Wilson

description of formations encountered

from to

P.O. Box 837

Lumb, Miss. 39440
 (mailing address)

Top Soil 0' 2'
Red Clay 2' 25'

WELL LOCATION:

sec 37 T 6 R 7
4 miles SE LANCLEASE
 (distance) (direction) (nearest town)

Red Coarse Sand + Gravel 25' 50'

WELL PURPOSE: None
 (home, irrigation, municipal, industrial)

Blue Clay 50' 54'

WELL COMPLETION DATA:

Red Coarse sand 54' 132'

(1) diameter (inches) 2"

Blue Clay 132' 135'

(2) total depth (feet) 135'

(3) static water level (feet) 29' below top of ground

(4) casing PVC, 120'
 (material) (depth)

2"
 (size) if telescope see back.

(5) screen 10', 120'
 (length) (depth to top)

2", PVC
 (size) (material)


(6) pump _____
 (HP) (yield gpm)

(type power)

(7) electric log no
 (yes or no)

(organization running log)

(8) how well bottom plugged Backwash valve

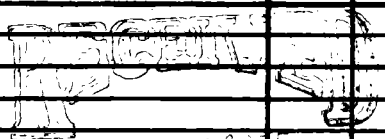


NOV - 4 - 85

DRILLERS REMARKS:
5' - 2" Tail Pipe

If well telescopes please sketch and show depths.

GROUND LEVEL

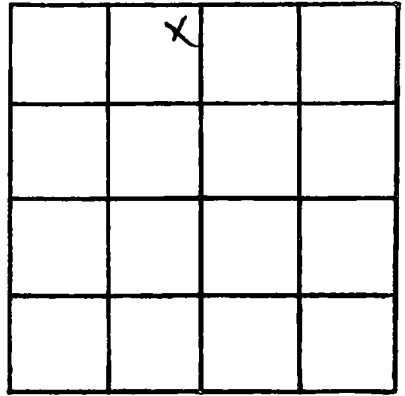

SECTION 37

Please indicate well location X.

ADDITIONAL INFORMATION

If more than one screen,
show locations of each on sketch.