

MISSISSIPPI DEPARTMENT OF NATURAL RESOURCES

Bureau of Land and Water Resources

Southport Mall

P.O. Box 10631

Jackson, Mississippi 39209

WATER WELL DRILLERS LOG

JACKSON  
K 22.05

6-20-85 19 date well completed  
 Paul Water Well Sew firm name  
 Jackson county well located

LANDOWNER: Robert E. Evans  
 15921 Roberts Rd  
 Vanclave, Miss.  
 (mailing address) 39564

WELL LOCATION:  
 sec 9 T 6 S R 7 E  
 IN miles of VANCLAVE  
 (distance) (direction) (nearest town)

WELL PURPOSE: Home  
 (home, irrigation, municipal, industrial)

WELL COMPLETION DATA:  
 (1) diameter (inches) 2"  
 (2) total depth (feet) 315'  
 (3) static water level (feet) 76 (below top of ground)  
 (4) casing PVC, 305' (material) (depth)  
 2" (size) if telescope see back.  
 (5) screen 10' (length), 305' (depth to top)  
 5" (size), PVC (material)  
 (6) pump 1/2 HP, 5 (yield gpm)  
 Elect. (type power)  
 (7) electric log No -  
 (organization running log)

(8) how well bottom plugged  
 Jack Wash Valve

description of formations encountered	from	to
Top soil	0	1'
Red Clay	1'	12'
Red Bone sand	12'	35'
Blue Clay	35'	192'
Blue Clay streak of sand	192'	270'
Blue Clay	270'	282'
Gray Brass sand	282'	315'

RECEIVED


NOV - 1 1985

DRILLERS REMARKS:

Department of Natural Resources  
 Bureau of Land & Water Resources

If well telescopes please sketch and show depths.

GROUND LEVEL

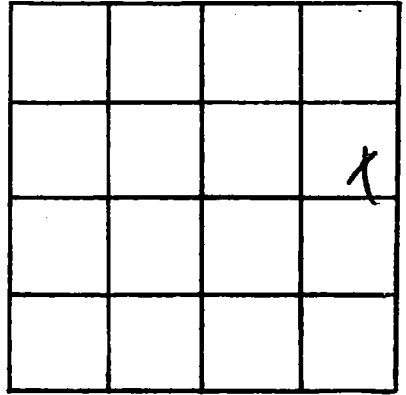

SECTION 9

Please indicate well location X.

ADDITIONAL INFORMATION

If more than one screen,  
show locations of each on sketch.