

MISSISSIPPI DEPARTMENT OF NATURAL RESOURCES

Bureau of Land and Water Resources

Southport Mall

P.O. Box 10631

Jackson, Mississippi 39209

WATER WELL DRILLERS LOG

JACKSON
K 2807

7-10-85
date well completed

Coast Water Well Sewer Jackson
firm name county well located

LANDOWNER:

Mike Ribon

description of formations encountered

from to

4.500 Harcourt St.
Vance, Miss.
(mailing address) 39264

Top soil 0 1'
Red & white Clay 1' 18'
White coarse sand 18' 38'
Blue Clay 38' 48'
Blue Clay & streak of sand 48' 70'
Red med. sand 70' 85'
Blue Clay 85' 88'

WELL LOCATION:

sec. 9 T. 6 S. R. 7 E.
1 N miles of Vance (distance) (direction) (nearest town)

WELL PURPOSE:

Home
(home, irrigation, municipal, industrial)

WELL COMPLETION DATA:

- (1) diameter (inches) 2"
- (2) total depth (feet) 88'
- (3) static water level (feet) 30' (below top of ground)
- (4) casing PVC 78' (material) (depth)
- 2" (size) if telescope see back.
- (5) screen 10' (length) 78' (depth to top)
- 2" (size) PVC (material)
- (6) pump 1/2 hp (HP) 6 (yield gpm)
- elec. (type power)
- (7) electric log No (yes or no)
- (organization running log)

(8) how well bottom plugged
Back West Valve

DRILLERS REMARKS:


RECEIVED

NOV - 5 1985

Department of Natural Resources
Bureau of Land & Water Resources

If well telescopes please sketch and show depths.

GROUND LEVEL

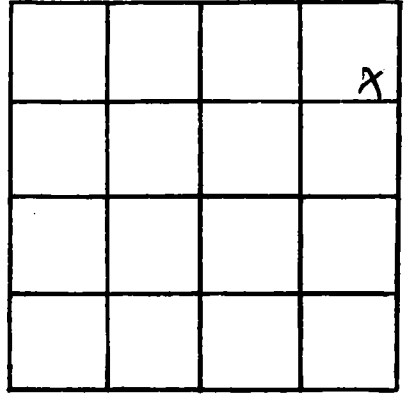

SECTION 9

Please indicate well location X.

ADDITIONAL INFORMATION

If more than one screen, show locations of each on sketch.