

MISSISSIPPI DEPARTMENT OF NATURAL RESOURCES

Bureau of Land and Water Resources

Southport Mall

P.O. Box 10631

Jackson, Mississippi 39209

WATER WELL DRILLERS LOG

JACKSON
K 2208

11-12-1985 date well completed
85-Coast Water Well Sew. firm name
Jackson county well located

LANDOWNER	description of formations encountered	from	to
Max Walter	Top soil	0	1'
Hwy 57- Vanhook, MS. 39546 (mailing address)	Brown Clay	1'	50'
	White Coarse sand	50'	75'
	Blue Clay	75'	100'
	White Coarse sand	100'	180'

WELL LOCATION:

sec. 29 T. 6 N. R. 7 W.
3 miles SOUTH of VANCELEW
(distance) (direction) (nearest town)

WELL PURPOSE: Home
(home, irrigation, municipal, industrial)

WELL COMPLETION DATA:


- (1) diameter (inches) 2"
- (2) total depth (feet) 180'
- (3) static water level (feet) 45' below top of ground
- (4) casing PVC 165'
(material) (depth)
2" (size) if telescope see back.
- (5) screen 10' 165'
(length) (depth to top)
- (6) pump 1 hp 9'
(HP) (yield gpm)
Electric (type power)
- (7) electric log No
(yes or no)

(organization running log)

(8) how well bottom plugged
Back Wash Valve

DRILLERS REMARKS:


2" PVC Turf pipe
7- Shovel Catcher

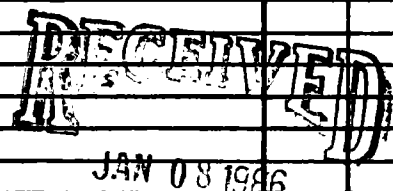

Department
Bureau of Land and Water Resources

If well telescopes please sketch and show depths.

GROUND LEVEL

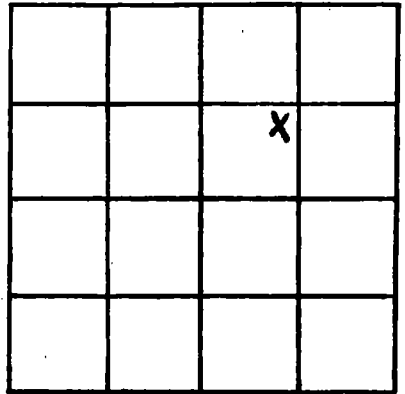

SECTION 29

Please indicate well location X.

ADDITIONAL INFORMATION

If more than one screen, show locations of each on sketch.