

MISSISSIPPI DEPARTMENT OF NATURAL RESOURCES
Bureau of Land and Water Resources
 Southport Mall
 P.O. Box 10631
 Jackson, Mississippi 39209
WATER WELL DRILLERS LOG

Jackson
 #2209

1-17-86 ¹⁹ Coastwater well Jackson
 date well completed firm name county well located

LANDOWNER: J.D. Warren
 13612 Tanner Rd
 Vanclave ms39564
 (mailing address)

WELL LOCATION:
 sec. 11 T. 6 S. R. 7 E.
 2 miles EAST of VANCLAVE
 (distance) (direction) (nearest town)

WELL PURPOSE: home
 (home, irrigation, municipal, industrial)

- WELL COMPLETION DATA:
- diameter (inches) 2"
 - total depth (feet) 145 ft
 - static water level (feet) 90 ft below top of ground
 - casing PVC, 130' (material), (depth)
 2" (size) if telescope see back.
 - screen 10' (length), 130' (depth to top)
 2" (size), PVC (material)
 - pump 2 hp. 9.5 (HP), (yield gpm)
 Elec (type power)
 - electric log No (yes or no)
 (organization running log)
 - how well bottom plugged


description of formations encountered	from	to
Top Soil	0	2
Red Clay	2	18
Red Coarse Sand	18	39
Purple Clay	39	65
Blue Clay	65	80
Red med Sand	80	140
Blue Clay	140	145

DRILLERS REMARKS:
 5ft 2" tailpipe

MAR 6 1986
 Department of Natural Resources
 Bureau of Land & Water Resources

If well telescopes please sketch and show depths.

GROUND LEVEL

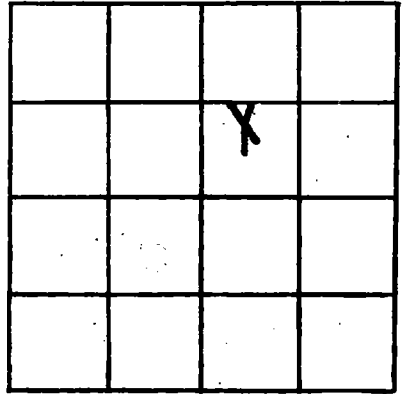

SECTION II

Please indicate well location X.

ADDITIONAL INFORMATION

If more than one screen,
show locations of each on sketch.