

**MISSISSIPPI DEPARTMENT OF NATURAL RESOURCES**  
**Bureau of Land and Water Resources**  
 Southport Mall  
 P.O. Box 10631  
 Jackson, Mississippi 39209  
**WATER WELL DRILLERS LOG**

Jackson  
 K 2210

7-7-86 19 Coastwater Well Jackson  
 date well completed firm name county well located

LANDOWNER: Carl Tanner  
 13443 Tanner Rd  
 Veneleave MS.  
 (mailing address)

WELL LOCATION:  
 sec 11 T 6N R 7E  
 2 miles East of Veneleave  
 (distance) (direction) (nearest town)

WELL PURPOSE: home  
 (home, irrigation, municipal, industrial)

WELL COMPLETION DATA:  
 (1) diameter (inches) 2"  
 (2) total depth (feet) 270'  
 (3) static water level (feet) 91' below top of ground  
 (4) casing PVC, 255' (material), (depth)  
 2" (size) if telescope see back.  
 (5) screen 10' (length), 255' (depth to top)  
 2" (size), PVC (material)  
 (6) pump 2 (HP), 9 1/2 (yield gpm)  
 Elect (type power)  
 (7) electric log no (yes or no)  
 (organization running log)  
 (8) how well bottom plugged backwash valve

description of formations encountered	from	to
Top Soil	0	1
Red Clay	1	18
Red med Sand	18	59
Blue Clay	59	80
Red coarse sand	80	150
Blue Clay	150	235
Gray Coarse sand	230	265
Blue Clay	265	270

**RECEIVED**


AUG 28 1986

Department of Natural Resources  
 Bureau of Land & Water Resources

DRILLERS REMARKS:  
 5'-2" PVC tail pipe

If well telescopes please sketch and show depths.

GROUND LEVEL

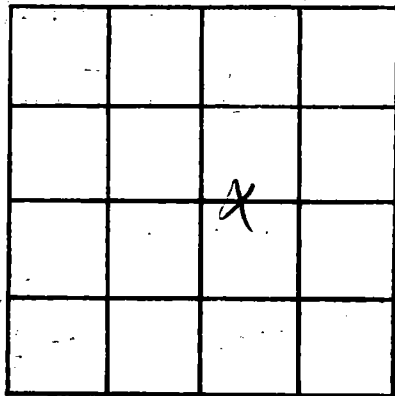

SECTION 11

Please indicate well location X.

ADDITIONAL INFORMATION

If more than one screen, show locations of each on sketch.