

MISSISSIPPI DEPARTMENT OF NATURAL RESOURCES

Bureau of Land and Water Resources

Southport Mall

P.O. Box 10631

Jackson, Mississippi 39209

WATER WELL DRILLERS LOG

Jackson
K2211

7-17-86
date well completed

Coast Water Well
firm name

Jackson
county well located

LANDOWNER: Paul Bosarge

description of formations encountered

from

to

4100 Twisted Run Lane

top soil

0 4

Ocean Springs ms
(mailing address)

red clay

4 18

WELL LOCATION:

Red clay + streak of sand

18 45

sec. 27 T 6 N R 7 E
3 miles SW of Vandevue
(distance) (direction) (nearest town)

Blue Clay

45 62

WELL PURPOSE: home
(home, irrigation, municipal, industrial)

Red Coarse Sand

62 143

WELL COMPLETION DATA:

Blue Clay

143 202

(1) diameter (inches) 2"
(2) total depth (feet) 230'
(3) static water level (feet) 40' below top of ground.

Blue Clay and streak of sand

202 210

(4) casing PVC, 215'
(material) (depth)

Gray Coarse Sand

210 225

2" If telescope see back.
(size)

Blue Clay

225 230

(5) screen 10, 215'
(length) (depth to top)

2" PVC
(size) (material)

(6) pump 1 hp, 9 gpm
(HP) (yield gpm)

elect
(type power)

(7) electric log no
(yes or no)

(organization running log)

(8) how well bottom plugged
backwash valve

DRILLERS REMARKS:

5' 2" PVC tail pipe


RECEIVED

AUG 26 1986

Department of Natural Resources
Bureau of Land & Water Resources

If well telescopes please sketch and show depths.

GROUND LEVEL

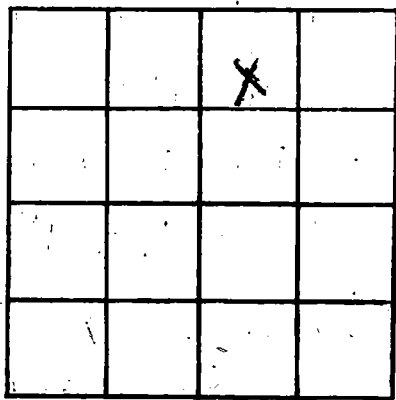

SECTION 27

Please indicate well location X.

ADDITIONAL INFORMATION

If more than one screen, show locations of each on sketch.