

MISSISSIPPI DEPARTMENT OF NATURAL RESOURCES

Bureau of Land and Water Resources

Southport Mall

P.O. Box 10631

Jackson, Mississippi 39209

WATER WELL DRILLERS LOG

Jackson
K 9915

5-5-86

Coastwater well svc. Jackson

date well completed

firm name

county well located

LANDOWNER

Mike Mattingly

description of formations encountered

from

to

Vandervee, Ms

(mailing address)

top soil

0 1

Blow clay

1 35

White coarse sand

35 60
Hole

WELL LOCATION:

sec. 25 T. 6 N. R. 7 E
3 1/2 miles SE of Vandervee
(distance) (direction) (nearest town)

WELL PURPOSE:

home
(home, irrigation, municipal, industrial)

WELL COMPLETION DATA:

- (1) diameter (inches) 2"
- (2) total depth (feet) 60'
- (3) static water level (feet) 20' below top of ground
- (4) casing PVC 45' (material) (depth)
2" (size) if telescope see back.
- (5) screen 10' 45' (length) (depth to top)
2" (size) PVC (material)
- (6) pump 1/2 (HP) (yield gpm)
Electric (type power)
- (7) electric log no (yes or no)

45 well
60
55

RECEIVED

AUG 20 1986

Department of Natural Resources
Bureau of Land & Water Resources


(8) how well bottom plugged
backwash valve

DRILLERS REMARKS:

5'-2" PVC tail pipe

If well telescopes please sketch and show depths.

GROUND LEVEL

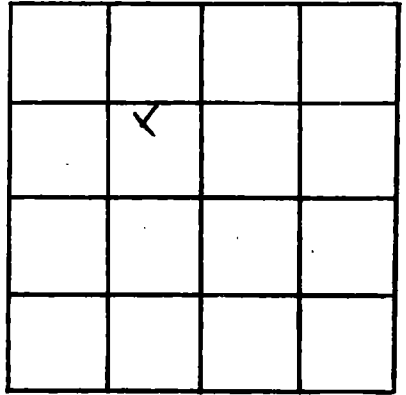

SECTION 25

Please indicate well location X.

ADDITIONAL INFORMATION

If more than one screen,
show locations of each on sketch.