

MISSISSIPPI DEPARTMENT OF NATURAL RESOURCES

Bureau of Land and Water Resources

Southport Mall

P.O. Box 10631

Jackson, Mississippi 39209

WATER WELL DRILLERS LOG

JACKSON
K2218

8-2-86
date well completed

19 Coast Water Well
firm name

Jackson
county well located

LANDOWNER: Tommy Forehand

Description of formations encountered

from

to

Forehand

12900 Horseman Ln.

(mailing address)

WELL LOCATION:

sec. 15 T 6 N R 7 E
1 miles (distance) E of Vanlease (nearest town)

Top Soil

0

1

Blue Clay

1

4

White Coarse Sand

4

30

Red Clay

30

32

White Coarse Sand

32

55

WELL PURPOSE: home
(home, irrigation, municipal, industrial)

WELL COMPLETION DATA:

(1) diameter (inches) 2"
(2) total depth (feet) 315'
(3) static water level (feet) 51' below top of ground.

Blue Clay

55

180

White Sand

180

194

Blue Clay

194

265

(4) casing PVC, 300'
(material) (depth)

Gray Coarse Sand

260

315

2" (size) if telescope see back.

(5) screen 10' 300'
(length) (depth to top)

2" PVC (size) (material)

(6) pump 1hp 8.5.
(HP) (yield gpm)

elect (type power)

(7) electric log no (yes or no)

(organization running log)

(8) how well bottom plugged backwash valve

DRILLERS REMARKS:

5 ft 2" PVC tail pipe

300
10
sidewell


RECEIVED

SEP 11 1986

Department of Natural Resources
Bureau of Land & Water Resources

If well telescopes please sketch and show depths.

GROUND LEVEL

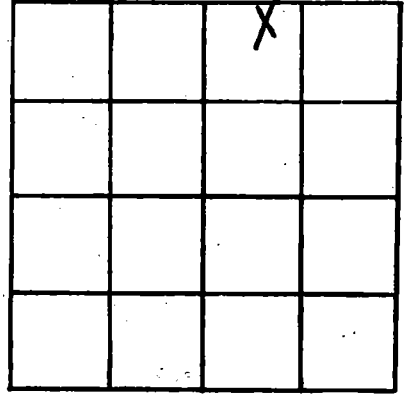

SECTION 15

Please indicate well location X.

ADDITIONAL INFORMATION

If more than one screen, show locations of each on sketch.