

MISSISSIPPI DEPARTMENT OF NATURAL RESOURCES

Bureau of Land and Water Resources

Southport Mall

P.O. Box 10631

Jackson, Mississippi 39209

WATER WELL DRILLERS LOG

JACKSON
K 2219

8-14-86 19 Coast water well Jackson
 date well completed firm name county well located

LANDOWNER: Paul Thrash
 5701 Swing Gate Lane
 Vancleave MS 39564
 (mailing address)

WELL LOCATION:
 sec. 5 T. 6 N R. 7 E
 (S) (W)
 2 miles NW of VANCELEAVE
 (distance) (direction) (nearest town)

WELL PURPOSE: home
 (home, irrigation, municipal, industrial)

WELL COMPLETION DATA:
 (1) diameter (inches) 2"
 (2) total depth (feet) 278'
 (3) static water level (feet) 67' below top of ground.
 (4) casing PVC, 263'
 (material) (depth)
 2" (size) if telescope see back.
 (5) screen 10', 263'
 (length) (depth to top)
 2" (size) PVC (material)
 (6) pump 1 (HP) 6.5 (yield gpm)
 Elect. (type power)
 (7) electric log no (yes or no)
 (organization running log)
 (8) how well bottom plugged backwashable

Description of formations encountered	from	to
Top Soil	0	3
Red Clay	3	19
Blue Clay	19	75
Red med Sand	75	120
Blue Clay	120	224
Gray Fine Sand	224	235
Gray Coarse Sand	235	273
Gray Coarse Sand and Gravel	273	278

RECEIVED


SEP 11 1986

Department of Natural Resources
 Bureau of Land & Water Resources

DRILLERS REMARKS:
 5'-2" PVC tail pipe

If well telescopes please sketch and show depths.

GROUND LEVEL

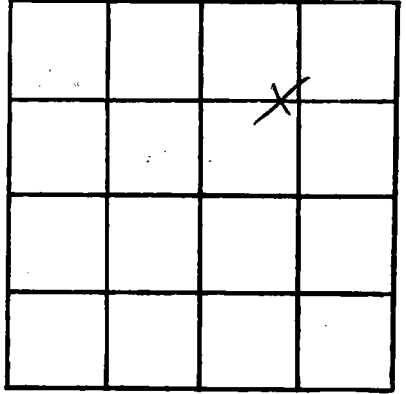

SECTION 5

Please indicate well location X.

ADDITIONAL INFORMATION

If more than one screen,
show locations of each on sketch.