

MISSISSIPPI DEPARTMENT OF NATURAL RESOURCES
Bureau of Land and Water Resources

P.O. Box 10631

Jackson, Mississippi 39209
WATER WELL DRILLERS LOG

COUNTY WELL LOCATED JACKSON	
WELL NUMBER K2923	CODED
DATE WELL COMPLETED 10-21-86	

PERMIT NUMBER
NAME OF DRILLING FIRM Coastwater well

NAME & MAILING ADDRESS OF LANDOWNER Ray Fortenberry PO Box 5037 Vandervee MS			
WELL LOCATION:	SEC 38	TOWNSHIP 6 S	RANGE 7 E
DISTANCE 2 Miles	DIRECTION NE	NEAREST TOWN Vandervee	
OTHER LANDMARK			
WELL PURPOSE: Home, Irrigation, Municipal, Industrial, Fish Pond, etc. home			

PUMP DATA		
PUMP TYPE (Circle One): Submersible, Turbine, <u>Jet</u> , Flowing Well, Other (Describe) _____		
POWER TYPE (Circle One): Electric, Tractor, Diesel, Gasoline, Butane, Other (Describe) _____		
Pump Capacity (GPM) _____	No. of Stages _____	Setting Depth _____ FT.
PUMP TEST		
Well yielded _____ GPM with a drawdown of _____ ft. after _____ hours of pumping		

WELL DATA		
Well Depth 270'	Casing Diameter (In.) 2"	Casing Length (Ft.) 260'
Type of Casing PVC	Hole Depth 270'	Depth to Static Water Level 60'
TYPE OF COMPLETION: (Circle One or More): Gravel Packed, Underreamed, Telescoped, <u>Natural Development</u> , Open Hole, Other		
Top of Lap Pipe or Reduction in Casing FEET IF TELESCOPED OR MORE THAN ONE SCREEN: USE BACK PAGE		

LOG DATA	
TYPE OF LOG RUN (Circle One): Electric, Gamma Ray, Density, Sonic, <u>No Log Run</u> , Neutron, Other (Describe) _____	
Name of Organization Running Log	

SCREEN DATA		
Diameter - Inches 2"	Length - Feet 10'	Slot Size - Inches .010
Screen Type PVC	Depth to Bottom - Feet 270'	


GEOLOGIC DATA (Office Use Only)			
Surface Elev.	Geologic Unit	Unit Thickness	Depth to Top
Subs. SWL	Date	Analysis	Aquifer Test

Driller's Remarks
RECEIVED

DESCRIPTION OF FORMATIONS ENCOUNTERED	FROM	TO	FORMATIONS (Continued)	FROM	TO
Top Soil	0	2	NOV 24 1986 Department of Natural Resources Bureau of Land & Water Resources		
Red Coarse Sand	2	18			
Brown Clay	18	45			
Blue Clay	45	104			
Gray Med Sand	104	110			
Blue Clay	110	146			
Fine Gray Sand	146	160			
Blue Clay	160	224			
Gray med Sand	224	255			
Gray Coarse Sand	255	270			
			IF MORE SPACE IS NEEDED, USE BACK		

If well telescopes please sketch and show depths.

GROUND LEVEL

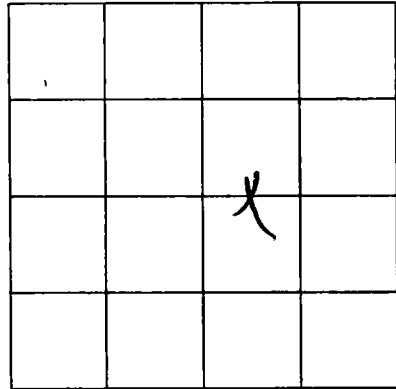

SECTION

34

Please indicate well location X.

ADDITIONAL INFORMATION

If more than one screen,
show location of each on sketch.