

MISSISSIPPI DEPARTMENT OF NATURAL RESOURCES
Bureau of Land and Water Resources

P.O. Box 10631
Jackson, Mississippi 39209
WATER WELL DRILLERS LOG

COUNTY WELL LOCATED Jackson	
WELL NUMBER R 2997	CODED
DATE WELL COMPLETED 3-17-87	

PERMIT NUMBER
NAME OF DRILLING FIRM Coast Water Well Serv. Inc.

NAME & MAILING ADDRESS OF LANDOWNER Sam Parnell			
P.O. Box 5062			
Vanceleve MS 39564			
WELL LOCATION:	SEC	TOWNSHIP	RANGE
	19	60 N	2 E
DISTANCE	DIRECTION	NEAREST TOWN	
2 Miles	SW	of Vanceleve	
OTHER LANDMARK			
WELL PURPOSE: Home, Irrigation, Municipal, Industrial, Fish Pond, etc. Home			

PUMP DATA		
PUMP TYPE (Circle One): Submersible, Turbine, Jet Flowing Well, Other (Describe)		
POWER TYPE (Circle One): Electric , Tractor, Diesel, Gasoline, Butane, Other (Describe)		
Pump Capacity (GPM) 10	No. of Stages 2	Setting Depth — FT.
PUMP TEST Well yielded — GPM with a drawdown of — ft. after — hours of pumping		

WELL DATA		
Well Depth 150	Casing Diameter (In.) 2	Casing Length (Ft.) 135
Type of Casing PVC	Hole Depth 150'	Depth to Static Water Level 26ft
TYPE OF COMPLETION: (Circle One or More): Gravel Packed , Underreamed, Telescoped, Natural Development, Open Hole, Other (Describe)		
Top of Lap Pipe or Reduction in Casing FEET IF TELESCOPED OR MORE THAN ONE SCREEN: USE BACK PAGE		

LOG DATA	
TYPE OF LOG RUN (Circle One): Electric, Gamma Ray, Density, Sonic, No Log Run , Neutron, Other (Describe)	
Name of Organization Running Log	

SCREEN DATA		
Diameter - Inches 2"	Length - Feet 10	Slot Size - Inches 008
Screen Type PVC	Depth to Bottom - Feet 145'	

GEOLOGIC DATA (Office Use Only)			
Surface Elev.	Geologic Unit	Unit Thickness	Depth to Top
Subs. SWL	Date	Analysis	Aquifer Test


Driller's Remarks

DESCRIPTION OF FORMATIONS ENCOUNTERED	FROM	TO
TOP SOIL	0	1
White Coarse sand	1	4
Red Clay	4	13
White Coarse sand	13	20
Blue Clay	20	40
Gray Coarse sand	40	103
Blue Clay	63	70
Gray Coarse sand	70	150

FORMATIONS (Continued)		FROM	TO
DRILLED			
MAY 21 1987			
Department of Natural Resources Bureau of Land & Water Resources			
IF MORE SPACE IS NEEDED, USE BACK			

If well telescopes please sketch and show depths.

GROUND LEVEL

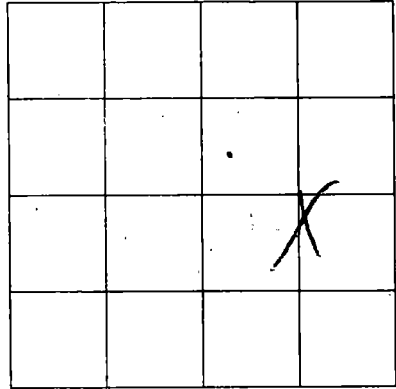

SECTION

19

Please indicate well location X.

ADDITIONAL INFORMATION

If more than one screen,
show location of each on sketch.