

**MISSISSIPPI DEPARTMENT OF NATURAL RESOURCES**  
Bureau of Land and Water Resources

P.O. Box 10631  
Jackson, Mississippi 39209  
**WATER WELL DRILLERS LOG**

COUNTY WELL LOCATED <b>Jackson</b>	
WELL NUMBER <b>R9999</b>	CODED
DATE WELL COMPLETED <b>4-14-87</b>	

PERMIT NUMBER
NAME OF DRILLING FIRM <b>Coast Water Well Svc. Inc.</b>

NAME & MAILING ADDRESS OF LANDOWNER <b>Larry Robertson Danner Rd Vanclave Mo</b>			
WELL LOCATION:	SEC	TOWNSHIP	RANGE
	<b>11</b>	<b>6<sup>N</sup> 7<sup>E</sup></b>	<b>7</b>
DISTANCE	DIRECTION	NEAREST TOWN	
<b>1</b> Miles	<b>E</b>	of <b>Vanclave</b>	
OTHER LANDMARK			
WELL PURPOSE: Home, Irrigation, Municipal, Industrial, Fish Pond, etc. <b>home</b>			

<b>PUMP DATA</b>		
PUMP TYPE (Circle One): Submersible, Turbine, <b>Jst</b> Flowing Well, Other (Describe) _____		
POWER TYPE (Circle One): <b>Electric</b> Tractor, Diesel, Gasoline, Butane, Other (Describe) _____		
Pump Capacity (GPM) <b>?</b>	No. of Stages <b>3</b>	Setting Depth <b>-</b> FT.
PUMP TEST		
Well yielded _____ GPM with a drawdown of _____ ft. after _____ hours of pumping		

<b>WELL DATA</b>		
Well Depth <b>231</b>	Casing Diameter (In.) <b>2"</b>	Casing Length (Ft.) <b>216'</b>
Type of Casing <b>PVC</b>	Hole Depth <b>236'</b>	Depth to Static Water Level <b>90 ft</b>
TYPE OF COMPLETION: (Circle One or More): Gravel Packed, Underreamed, Telescoped, <b>Natural Development</b> , Open Hole, Other (Describe) _____		
Top of Lap Pipe or Reduction in Casing		
FEET	IF TELESCOPED OR MORE THAN ONE SCREEN: USE BACK PAGE	

<b>LOG DATA</b>	
TYPE OF LOG RUN (Circle One): Electric, Gamma Ray, Density, Sonic, <b>No Log RUN</b> , Other (Describe) _____	
Name of Organization Running Log	

<b>SCREEN DATA</b>		
Diameter - Inches <b>2"</b>	Length - Feet <b>15'</b>	Slot Size - Inches <b>.008</b>
Screen Type <b>PVC</b>	Depth to Bottom - Feet <b>231'</b>	


<b>GEOLOGIC DATA (Office Use Only)</b>			
Surface Elev.	Geologic Unit	Unit Thickness	Depth to Top
Subs. SWL	Date	Analysis	Aquifer Test
Driller's Remarks			

DESCRIPTION OF FORMATIONS ENCOUNTERED	FROM	TO
<b>Top Sand</b>	<b>0</b>	<b>2</b>
<b>White Coarse Sand</b>	<b>2</b>	<b>10</b>
<b>Brown Clay</b>	<b>10</b>	<b>13</b>
<b>White Coarse Sand</b>	<b>13</b>	<b>22</b>
<b>Blue Clay</b>	<b>22</b>	<b>85</b>
<b>White Coarse Sand</b>	<b>85</b>	<b>140</b>
<b>Blue Clay</b>	<b>140</b>	<b>214</b>
<b>Gray Med Sand</b>	<b>214</b>	<b>231</b>
<b>Blue Clay</b>	<b>231</b>	<b>234</b>

FORMATIONS (Continued)	FROM	TO
<b>PROBLY</b>		
<b>MAY 27 1987</b>		
Department of Natural Resources Bureau of Land & Water Resources		
IF MORE SPACE IS NEEDED, USE BACK		

If well telescopes please sketch and show depths.

GROUND LEVEL

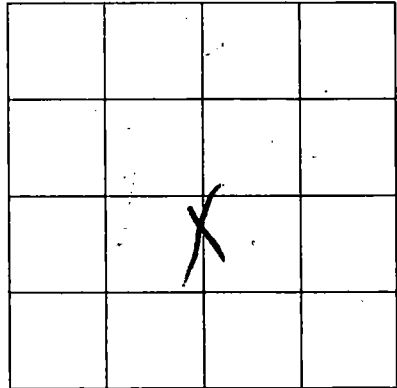

SECTION 11

Please indicate well location X.

ADDITIONAL INFORMATION

If more than one screen,  
show location of each on sketch.