

MISSISSIPPI DEPARTMENT OF NATURAL RESOURCES
Bureau of Land and Water Resources

P.O. Box 10631
Jackson, Mississippi 39209
WATER WELL DRILLERS LOG

COUNTY WELL LOCATED Jackson	
WELL NUMBER K 2230	CODED
DATE WELL COMPLETED 9230 4-22-87	

PERMIT NUMBER
NAME OF DRILLING FIRM Coast Water Well Svc. Inc.

NAME & MAILING ADDRESS OF LANDOWNER Virgil Harper Paige Bayou Rd Vandeventer Ms		
WELL LOCATION: SEC	TOWNSHIP	RANGE
27	6	7
DISTANCE	DIRECTION	NEAREST TOWN
3 Miles	SE of	Vandeventer
OTHER LANDMARK		
WELL PURPOSE: Home, Irrigation, Municipal, Industrial, Fish Pond, etc. home.		

PUMP DATA		
PUMP TYPE (Circle One): Submersible, Turbine, Jet, Flowing Well, Other (Describe) _____		
POWER TYPE (Circle One): Electric, Tractor, Diesel, Gasoline, Butane, Other (Describe) _____		
Pump Capacity (GPM)	No. of Stages	Setting Depth FT.
PUMP TEST		
Well yielded _____ GPM with a drawdown of _____ ft. after _____ hours of pumping		

WELL DATA		
Well Depth 408'	Casing Diameter (In.) 3 2"	Casing Length (Ft.) 383'
Type of Casing PVC	Hole Depth 408'	Depth to Static Water Level 40'

LOG DATA	
TYPE OF LOG RUN (Circle One): Electric, Gamma Ray, Density, Sonic, Neutron, Other (Describe) _____	
Name of Organization Running Log	

TYPE OF COMPLETION: (Circle One or More): Gravel Packed, Underreamed, Telescoped, Natural Development , Open Hole, Other	
Top of Lap Pipe or Reduction in Casing	
FEET	IF TELESCOPED OR MORE THAN ONE SCREEN: USE BACK PAGE

GEOLOGIC DATA (Office Use Only)			
Surface Elev.	Geologic Unit	Unit Thickness	Depth to Top
Subs. SWL	Date	Analysis	Aquifer Test

SCREEN DATA		
Diameter - Inches 2"	Length - Feet 20'	Slot Size - Inches .008
Screen Type pvc	Depth to Bottom - Feet 403'	

Driller's Remarks

DESCRIPTION OF FORMATIONS ENCOUNTERED	FROM	TO	FORMATIONS (Continued)	FROM	TO
Top Soil	0	1			
White Coarse Sand	1	145			
Blue Clay	145	355			
Gray Med Sand	355	403			
Blue Clay	403	408			

RECEIVED


MAY 21 1987

Department of Natural Resources
Bureau of Land & Water Resources

IF MORE SPACE IS NEEDED, USE BACK

If well telescopes please sketch and show depths.

GROUND LEVEL

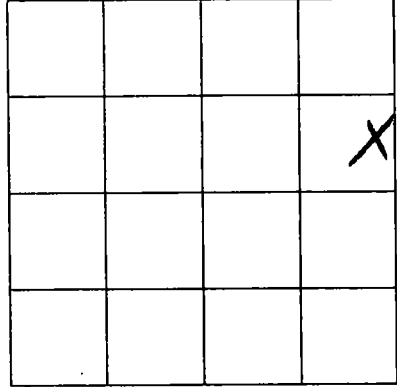

SECTION 27

Please indicate well location X.

ADDITIONAL INFORMATION

If more than one screen,
show location of each on sketch.