

MISSISSIPPI DEPARTMENT OF NATURAL RESOURCES

Bureau of Land and Water Resources

P.O. Box 10631

Jackson, Mississippi 39209

WATER WELL DRILLERS LOG

COUNTY WELL LOCATED Jackson
WELL NUMBER CODED R223B
DATE WELL COMPLETED 4-9-87

PERMIT NUMBER
NAME OF DRILLING FIRM Coast Water Well Svc Inc

NAME & MAILING ADDRESS OF LANDOWNER Mr James Platt			
11801 Wave Lake Rd			
Vandœuvre, MS 39564			
WELL LOCATION: SEC	TOWNSHIP	RANGE	
24	6	7	
DISTANCE		DIRECTION	
3 Miles		SE of VANCLIFF	
OTHER LANDMARK			
WELL PURPOSE: Home, Irrigation, Municipal, Industrial, Fish Pond, etc. home			

PUMP DATA		
PUMP TYPE (Circle One): Submersible, Turbine, Jet, Flowing Well, Other (Describe) _____		
POWER TYPE (Circle One): Electric, Tractor, Diesel, Gasoline, Butane, Other (Describe) _____		
Pump Capacity (GPM)	No. of Stages	Setting Depth FT.
PUMP TEST		
Well yielded _____ GPM with a drawdown of _____ ft. after _____ hours of pumping		

WELL DATA		
Well Depth 35' 30"	Casing Diameter (In.) 2"	Casing Length (Ft.) 20'
Type of Casing PVC	Hole Depth 35'	Depth to Static Water Level 7 ft
TYPE OF COMPLETION: (Circle One or More) Gravel Packed, Underreamed, Telescoped, Natural Development, Open Hole, Other (Describe)		
Top of Lap Pipe or Reduction in Casing FEET IF TELESCOPED OR MORE THAN ONE SCREEN: USE BACK PAGE		

LOG DATA	
TYPE OF LOG RUN (Circle One): Electric, Gamma Ray, Density, Sonic, Neutron, Other (Describe) _____ No Log Run	
Name of Organization Running Log	

SCREEN DATA		
Diameter - Inches 2"	Length - Feet 10'	Slot Size - Inches 008
Screen Type PVC		Depth to Bottom - Feet 30'

GEOLOGIC DATA (Office Use Only)			
Surface Elev.	Geologic Unit	Unit Thickness	Depth to Top
Subs. SWL	Date	Analysis	Aquifer Test

Driller's Remarks

DESCRIPTION OF FORMATIONS ENCOUNTERED	FROM	TO
Top Soil	0	2
White Coarsd Sand	2	5
Brown Clay	5	14
Black Clay	14	16
White Coarsd Sand	16	33

RECEIVED


SEP 21 1987

Department of Natural Resources
Bureau of Land & Water Resources

IF MORE SPACE IS NEEDED, USE BACK

If well telescopes please sketch and show depths.

GROUND LEVEL

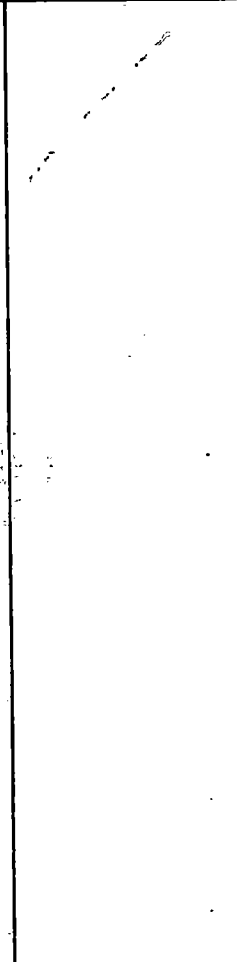

		X	

SECTION 24

Please indicate well location X.

ADDITIONAL INFORMATION

PREPARED
 BY: _____
 DATE: _____

If more than one screen, show location of each on sketch.

If more than one screen, show location of each on sketch.