

add - loc - pump
MISSISSIPPI DEPARTMENT OF NATURAL RESOURCES
 Bureau of Land and Water Resources

P.O. Box 10631
 Jackson, Mississippi 39209
WATER WELL DRILLERS LOG

COUNTY WELL LOCATED Jackson	
WELL NUMBER R2236	CODED
DATE WELL COMPLETED 7-31-87	

PERMIT NUMBER
NAME OF DRILLING FIRM Coast Water Well Svc.

NAME & MAILING ADDRESS OF LANDOWNER Sony Miller Forrest Crest Lane Vandave MS		
WELL LOCATION: 19 6 S 7 W		
DISTANCE 3 Miles	DIRECTION SW	NEAREST TOWN Vandave
OTHER LANDMARK		
WELL PURPOSE: Home, Irrigation, Municipal, Industrial, Fish Pond, etc. home		

PUMP DATA		
PUMP TYPE (Circle One): Submersible, Turbine, Jet, Flowing Well, Other (Describe)		
POWER TYPE (Circle One): Electric, Tractor, Diesel, Gasoline, Butane, Other (Describe)		
Pump Capacity (GPM)	No. of Stages	Spring Depth FT.
PUMP TEST Well yielded _____ GPM with a drawdown of _____ ft. after _____ hours of pumping		

WELL DATA		
Well Depth 355'	Casing Diameter (In.) 2"	Casing Length (Ft.) 345'
Type of Casing PVC	Hole Depth 360'	Depth to Static Water Level 65'
TYPE OF COMPLETION: (Circle One or More): Gravel Packed, Underreamed, Telescoped, Natural Development, Open Hole, Other (Describe)		
Top of Lap Pipe or Reduction in Casing FEET IF TELESCOPED OR MORE THAN ONE SCREEN: USE BACK PAGE		


LOG DATA		
TYPE OF LOG RUN (Circle One): Electric, Gamma Ray, Density, Sonic, Neutron, Other (Describe) No Log Run		
Name of Organization Running Log		

SCREEN DATA		
Diameter - Inches 2"	Length - Feet 10'	Slot Size - Inches .008
Screen Type PVC	Depth to Bottom Feet 355'	

GEOLOGIC DATA (Office Use Only)			
Surface Elev.	Geologic Unit	Unit Thickness	Depth to Top
Subs. SWL	Date	Analysis	Aquifer Test

Driller's Remarks	

DESCRIPTION OF FORMATIONS ENCOUNTERED	FROM	TO
Top Soil	0	2
Brown Clay	2	18
Gray Med Sand	18	22
Blue Clay	22	26
Brown Coarse Sand	26	193
Blue Clay	193	320
Gray Coarse Sand	320	355
Blue Clay	355	360




SEP 21 1987

**Department of Natural Resources
Bureau of Land & Water Resources**

FORM NO. 100 (Rev. 1-77)	IF MORE SPACE IS NEEDED, USE BACK
--------------------------	-----------------------------------

If well telescopes please sketch and show depths.

GROUND LEVEL

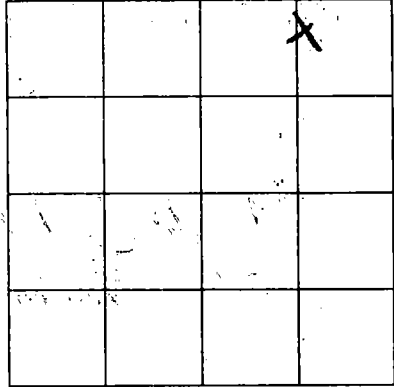

SECTION 19

Please indicate well location X.

ADDITIONAL INFORMATION

REPRODUCTION
OF
THIS
DOCUMENT
IS
PROHIBITED

THIS DOCUMENT IS THE PROPERTY OF THE
BUREAU OF LAND MANAGEMENT AND IS TO BE
RETURNED TO THE BUREAU OF LAND MANAGEMENT

If more than one screen,
show location of each on sketch.