

100.

MISSISSIPPI DEPARTMENT OF NATURAL RESOURCES  
Bureau of Land and Water Resources

COUNTY WELL LOCATED  
**Jackson**

WELL NUMBER  
**R 2258**

DATE WELL COMPLETED  
**6-19-87**

PERMIT NUMBER

NAME OF DRILLING FIRM  
**Coast Water Well Service**

P.O. Box 10631  
Jackson, Mississippi 39209  
WATER WELL DRILLERS LOG

NAME & MAILING ADDRESS OF LANDOWNER  
**Earl Burney**  
**5413 Burney Rd**  
**Vandœuvre MS**

WELL LOCATION: SEC **9** TOWNSHIP **6 S** RANGE **7 W**

DISTANCE **1** Miles DIRECTION **NW** of NEAREST TOWN **Vandœuvre**

OTHER LANDMARK

WELL PURPOSE: Home, Irrigation, Municipal, Industrial, Fish Pond, etc.  
**home**

PUMP DATA

PUMP TYPE (Circle One):  
Submersible, Turbine, **Jet**, Flowing Well,  
Other (Describe)

POWER TYPE (Circle One):  
**Electric**, Tractor, Diesel, Gasoline, Butane,  
Other (Describe)

Pump Capacity (GPM) **9** No. of Stages **2** Setting Depth **—** FT.

PUMP TEST

Well yielded **—** GPM with  
a drawdown of **—** ft.  
after **—** hours of pumping

WELL DATA

Well Depth **270'** Casing Diameter (In.) **2 1/2"** Casing Length (Ft.) **255'**

Type of Casing **PVC** Hole Depth **270'** Depth to Static Water Level **30'**

TYPE OF COMPLETION: (Circle One or More):  
**Gravel Packed**, Underreamed, Telescoped,  
**Natural Development**, Open Hole, Other

Top of Lap Pipe or Reduction in Casing

FEET IF TELESCOPED OR MORE THAN ONE SCREEN: USE BACK PAGE

LOG DATA

TYPE OF LOG RUN (Circle One):  
Electric, Gamma Ray, Density, Sonic, **No Log Run**,  
Other (Describe)

Name of Organization Running Log

SCREEN DATA

Diameter - Inches **2"** Length - Feet **10'** Slot Size - Inches **.008**

Screen Type **PVC** Depth to Bottom - Feet **265'**

GEOLOGIC DATA (Office Use Only)

Surface Elev.	Geologic Unit	Unit Thickness	Depth to Top
Subs. SWL	Date	Analysis	Aquifer Test

Driller's Remarks

DESCRIPTION OF FORMATIONS ENCOUNTERED	FROM	TO
<b>Top Soil</b>	<b>0</b>	<b>2</b>
<b>Brown Clay</b>	<b>2</b>	<b>35</b>
<b>Blue Coarsesand</b>	<b>35</b>	<b>87</b>
<b>Blue Clay</b>	<b>87</b>	<b>230</b>
<b>Med Gray sand</b>	<b>230</b>	<b>265</b>
<b>Blue clay</b>	<b>265</b>	<b>270</b>

**RECEIVED**


**SEP 21 1987**

Department of Natural Resources  
Bureau of Land & Water Resources

IF MORE SPACE IS NEEDED, USE BACK

If well telescopes please  
sketch and show depths.

GROUND LEVEL

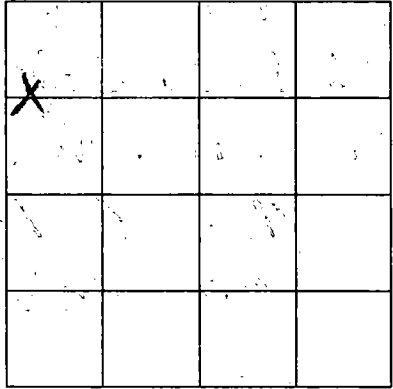

SECTION 9

Please indicate well location X.

ADDITIONAL INFORMATION

Lined area for additional information.

**DAVIDSON**

DAVIDSON

If more than one screen,  
show location of each on sketch.