

MISSISSIPPI DEPARTMENT OF NATURAL RESOURCES
Bureau of Land and Water Resources

P.O. Box 10631
Jackson, Mississippi 39209
WATER WELL DRILLERS LOG

COUNTY WELL LOCATED Jackson
WELL NUMBER (CODED) R2229
DATE WELL COMPLETED 6-9-87

PERMIT NUMBER
NAME OF DRILLING FIRM Coast Water Well Svc.

NAME & MAILING ADDRESS OF LANDOWNER Elmer Johnston		
Lot 2641 Sleg Pines		
Gautier MS 39553		
WELL LOCATION: SEC	TOWNSHIP	RANGE
27	6	7
DISTANCE	DIRECTION	NEAREST TOWN
3 Miles	SE	Vanclave
OTHER LANDMARK		
WELL PURPOSE: Home Irrigation, Municipal, Industrial, Fish Pond, etc. home		

PUMP DATA		
PUMP TYPE (Circle One): Submersible, Turbine, Jet Flowing Well, Other (Describe) _____		
POWER TYPE (Circle One): Electric , Tractor, Diesel, Gasoline, Butane, Other (Describe) _____		
Pump Capacity (GPM) 6	No. of Stages 1	Setting Depth FT.
PUMP TEST		
Well yielded _____ GPM with a drawdown of _____ ft. after _____ hours of pumping		

WELL DATA		
Well Depth 130'	Casing Diameter (In.) 2"	Casing Length (Ft.) 120'
Type of Casing PVC	Hole Depth 130'	Depth to Static Water Level 30'
TYPE OF COMPLETION: (Circle One or More): Gravel Packed, Underreamed, Telescoped, Natural Development , Open Hole, Other (Describe) _____		
Top of Lap Pipe or Reduction in Casing FEET IF TELESCOPED OR MORE THAN ONE SCREEN: USE BACK PAGE		

LOG DATA	
TYPE OF LOG RUN (Circle One): Electric, Gamma Ray, Density, Sonic, Neutron , Other (Describe) _____	
Name of Organization Running Log	

SCREEN DATA		
Diameter - Inches 2"	Length - Feet 10'	Slot Size - Inches .010
Screen Type PVC	Depth to Bottom - Feet 130'	


GEOLOGIC DATA (Office Use Only)			
Surface Elev.	Geologic Unit	Unit Thickness	Depth to Top
Subs. SWL	Date	Analysis	Aquifer Test
Driller's Remarks			

DESCRIPTION OF FORMATIONS ENCOUNTERED	FROM	TO
Red Clay	0	13
White Clay w/ streaks of sand	13	30
Brown coarse sand w/ streaks of clay	30	95
Brown coarse sand	95	130

RECEIVED	
SEP 21 1987	
Department of Natural Resources Bureau of Land & Water Resources	
IF MORE SPACE IS NEEDED, USE BACK	

If well telescopes please
sketch and show depths.


GROUND LEVEL

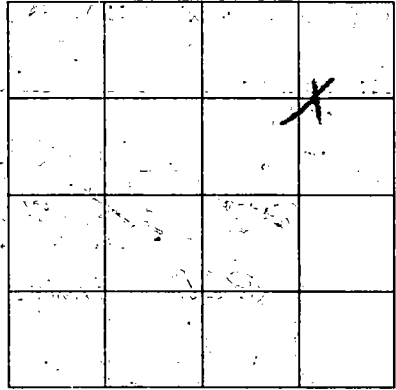

SECTION 27

Please indicate well location X.

ADDITIONAL INFORMATION

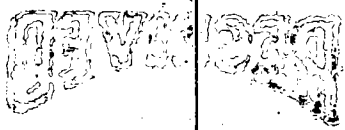

If more than one screen,
show location of each on sketch.