

~~MISSISSIPPI~~ ~~DEPARTMENT~~ ~~OF~~ ~~NATURAL~~ ~~RESOURCES~~
MISSISSIPPI DEPARTMENT OF NATURAL RESOURCES
 Bureau of Land and Water Resources

P.O. Box 10631

Jackson, Mississippi 39209

WATER WELL DRILLERS LOG

COUNTY WELL LOCATED
Jackson

WELL NUMBER CODED
K 2246

DATE WELL COMPLETED
9-2-87

PERMIT NUMBER

NAME OF DRILLING FIRM
Coastwater Well SVC Inc.

NAME & MAILING ADDRESS OF LANDOWNER
L.B. Jones

527 Front Beach Dr.

Ocean Springs, Ms 39564

WELL LOCATION: SEC TOWNSHIP RANGE
6 6 7

DISTANCE DIRECTION NEAREST TOWN
3 Miles **W** of **VAN CLEAVE**

OTHER LANDMARK

WELL PURPOSE: Home, Irrigation, Municipal, Industrial, Fish Pond, etc.
home

PUMP DATA

PUMP TYPE (Circle One):
 Submersible, Turbine, **Jet** Flowing Well,
 Other (Describe) _____

POWER TYPE (Circle One):
 Electric, Tractor, Diesel, Gasoline, Butane,
 Other (Describe) _____

Pump Capacity (GPM)	No. of Stages	Setting Depth
12	2	- FT.

PUMP TEST

Well yielded _____ GPM with
 a drawdown of _____ ft.
 after _____ hours of pumping

WELL DATA

Well Depth 255'	Casing Diameter (In.) 2"	Casing Length (Ft.) 245'
Type of Casing PVC	Hole Depth 260'	Depth to Static Water Level 25'

TYPE OF COMPLETION: (Circle One or More):
 Gravel Packed, Underreamed, Telescoped,
 Natural Development, Open Hole, Other
 (Describe) _____

Top of Lap Pipe or Reduction in Casing

FEET IF TELESCOPED OR MORE THAN ONE SCREEN: USE BACK PAGE

LOG DATA

TYPE OF LOG RUN (Circle One):
 Electric, Gamma Ray, Density, Sonic, **No Log Run**,
 Other (Describe) _____

Name of Organization Running Log

SCREEN DATA

Diameter - Inches 2"	Length - Feet 10'	Slot Size - Inches .008
Screen Type PVC	Depth to Bottom - Feet 255'	

GEOLOGIC DATA (Office Use Only)

Surface Elev.	Geologic Unit	Unit Thickness	Depth to Top
Subs. SWL	Date	Analysis	Aquifer Test

Driller's Remarks


RECEIVED

DESCRIPTION OF FORMATIONS ENCOUNTERED	FROM	TO	FORMATIONS (Continued)	FROM	TO
White Coarse Sand	0	18	MAY 24 1988 Department of Natural Resources Bureau of Land & Water Resources		
White Clay	18	30			
Gray Coarse Sand	30	58			
Blue Clay	58	60			
Gray Coarse Sand	58	58			
Blue Clay	60	70			
Brown Coarse Sand + Gravel	70	78			
Blue Clay	78	258			
Gray Coarse Sand	258	260			
Blue Clay					

IF MORE SPACE IS NEEDED, USE BACK

If well telescopes please sketch and show depths.

GROUND LEVEL

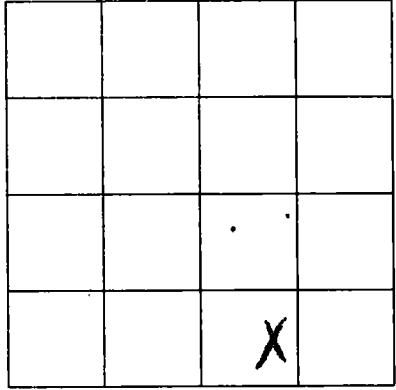

SECTION 6

Please indicate well location X.

ADDITIONAL INFORMATION

A series of horizontal lines for writing additional information.

If more than one screen, show location of each on sketch.