

MISSISSIPPI DEPARTMENT OF NATURAL RESOURCES
Bureau of Land and Water Resources

P.O. Box 10631

Jackson, Mississippi 39209
WATER WELL DRILLERS LOG

COUNTY WELL LOCATED
Jackson

WELL NUMBER
K2260

CODED

DATE WELL COMPLETED
9-8-88

PERMIT NUMBER

NAME OF DRILLING FIRM
Best Water Well

NAME & MAILING ADDRESS OF LANDOWNER
Tip Dues

PO Box 5026

Vandeventer mo

WELL LOCATION: SEC *29* TOWNSHIP *6* RANGE *30*

DISTANCE *2* Miles DIRECTION *S* NEAREST TOWN *Vandeventer*

OTHER LANDMARK

WELL PURPOSE: Home, Irrigation, Municipal, Industrial, Fish Pond, etc.
home

PUMP DATA

PUMP TYPE (Circle One): Submersible, Turbine, Jet, Flowing Well, Other (Describe) _____

POWER TYPE (Circle One): Electric, Tractor, Diesel, Gasoline, Butane, Other (Describe) _____

Pump Capacity (GPM) *15* No. of Stages *2* Setting Depth _____ FT.

PUMP TEST

Well yielded _____ GPM with a drawdown of _____ ft. after _____ hours of pumping

WELL DATA

Well Depth <i>143'</i>	Casing Diameter (In.) <i>2"</i>	Casing Length (Ft.) <i>138'</i>
Type of Casing <i>PVC</i>	Hole Depth <i>143'</i>	Depth to Static Water Level <i>5'</i>

TYPE OF COMPLETION: (Circle One or More): Gravel Packed, Underreamed, Telescoped, Natural Development, Open Hole, Other

Top of Lap Pipe or Reduction in Casing

FEET IF TELESCOPED OR MORE THAN ONE SCREEN: USE BACK PAGE

LOG DATA

TYPE OF LOG RUN (Circle One): No Log Run, Electric, Gamma Ray, Density, Sonic, Neutron, Other (Describe) _____

Name of Organization Running Log

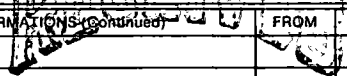
SCREEN DATA

Diameter - Inches <i>2"</i>	Length - Feet <i>10'</i>	Slot Size - Inches <i>.008</i>
Screen Type <i>PVC</i>	Depth to Bottom - Feet <i>138'</i>	

GEOLOGIC DATA (Office Use Only)

Surface Elev.	Geologic Unit	Unit Thickness	Depth to Top
Subs. SWL	Date	Analysis	Aquifer Test

Driller's Remarks

DESCRIPTION OF FORMATIONS ENCOUNTERED	FROM	TO	FORMATIONS (continued)	FROM	TO
<i>Pink Sandy silt</i>	<i>0</i>	<i>5</i>	 NOV 15 1988 Department of Natural Resources Bureau of Land & Water Resources		
<i>Red Clay</i>	<i>5</i>	<i>10</i>			
<i>Pink med. Sand</i>	<i>10</i>	<i>28</i>			
<i>Red Clay</i>	<i>28</i>	<i>40</i>			
<i>Blue Clay</i>	<i>40</i>	<i>50</i>			
<i>Gray med. Sand</i>	<i>50</i>	<i>60</i>			
<i>Brown Coarse Sand</i>	<i>60</i>	<i>105</i>			
<i>Red Coarse Sand</i>	<i>105</i>	<i>120</i>			
<i>Gray Coarse Sand</i>	<i>120</i>	<i>138</i>			
<i>Blue Clay</i>	<i>138</i>	<i>143</i>			

IF MORE SPACE IS NEEDED, USE BACK

If well telescopes please
sketch and show depths.

GROUND LEVEL

			X

SECTION 29

Please indicate well location X.

ADDITIONAL INFORMATION

If more than one screen,
show location of each on sketch.