

MISSISSIPPI DEPARTMENT OF NATURAL RESOURCES
Bureau of Land and Water Resources

P.O. Box 10631

Jackson, Mississippi 39209
WATER WELL DRILLERS LOG

COUNTY WELL LOCATED <i>Jackson</i>		PERMIT NUMBER
WELL NUMBER <i>K 20067</i>	CODED	NAME OF DRILLING FIRM <i>West Water Well Sew.</i>
DATE WELL COMPLETED <i>8-11-88</i>		

NAME & MAILING ADDRESS OF LANDOWNER <i>Myrtle Waltman</i>		
<i>Headstart Rd.</i>		
<i>Vandover MS</i>		
WELL LOCATION: SEC	TOWNSHIP	RANGE
<i>10</i>	<i>6</i>	<i>7</i>
DISTANCE <i>1</i> Miles	DIRECTION <i>EAST</i> of	NEAREST TOWN <i>VANCLIFF</i>
OTHER LANDMARK		
WELL PURPOSE: Home, Irrigation, Municipal, Industrial, Fish Pond, etc. <i>Home</i>		

PUMP DATA		
PUMP TYPE (Circle One): Submersible, Turbine, <u>Jet</u> Flowing Well, Other (Describe) _____		
POWER TYPE (Circle One): <u>Electric</u> , Tractor, Diesel, Gasoline, Butane, Other (Describe) _____		
Pump Capacity (GPM) <i>8</i>	No. of Stages <i>2</i>	Setting Depth _____ FT.
PUMP TEST		
Well yielded _____ GPM with a drawdown of _____ ft. after _____ hours of pumping		

WELL DATA		
Well Depth <i>125'</i>	Casing Diameter (In.) <i>2"</i>	Casing Length (Ft.) <i>110'</i>
Type of Casing <i>PVC</i>	Hole Depth <i>125'</i>	Depth to Static Water Level <i>50'</i>
TYPE OF COMPLETION: (Circle One or More): <u>Gravel Packed</u> , Underreamed, Telescoped, <u>Natural Development</u> , Open Hole, Other (Describe) _____		
Top of Lap Pipe or Reduction in Casing FEET _____ IF TELESCOPED OR MORE THAN ONE SCREEN: USE BACK PAGE		

LOG DATA	
TYPE OF LOG RUN (Circle One): Electric, Gamma Ray, Density, Sonic, Neutron, Other (Describe) _____ <u>No Log Run</u>	
Name of Organization Running Log	

SCREEN DATA		
Diameter - Inches <i>2"</i>	Length - Feet <i>10'</i>	Slot Size - Inches <i>.008</i>
Screen Type <i>PVC</i>	Depth to Bottom - Feet <i>120'</i>	

GEOLOGIC DATA (Office Use Only)			
Surface Elev.	Geologic Unit	Unit Thickness	Depth to Top
Subs. SWL	Date	Analysis	Aquifer Test

Driller's Remarks

RECEIVED

DESCRIPTION OF FORMATIONS ENCOUNTERED	FROM	TO	FORMATIONS (Continued)	FROM	TO
<i>Top Sand</i>	<i>0</i>	<i>2</i>			
<i>Brown Clay</i>	<i>2</i>	<i>17</i>			
<i>White Coarse Sand</i>	<i>17</i>	<i>35'</i>			
<i>Blue Clay</i>	<i>35</i>	<i>74</i>			
<i>White Coarse Sand</i>	<i>74</i>	<i>125'</i>			


NOV 15 1988

Department of Natural Resources
Bureau of Land & Water Resources

IF MORE SPACE IS NEEDED, USE BACK

If well telescopes please sketch and show depths.

GROUND LEVEL

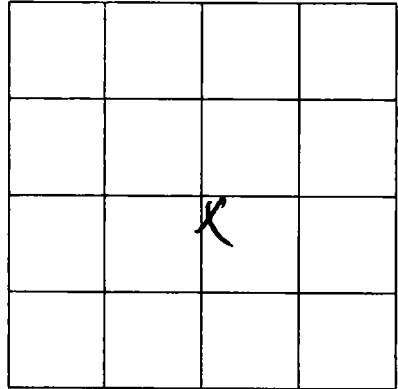

SECTION 10

Please indicate well location X.

ADDITIONAL INFORMATION

If more than one screen,
show location of each on sketch.