

MISSISSIPPI DEPARTMENT OF NATURAL RESOURCES
Bureau of Land and Water Resources

P.O. Box 10631
Jackson, Mississippi 39209
WATER WELL DRILLERS LOG

COUNTY WELL LOCATED <i>Jackson</i>	
WELL NUMBER <i>R 977A</i>	CODED
DATE WELL COMPLETED <i>5-4-88</i>	

PERMIT NUMBER
NAME OF DRILLING FIRM <i>Cook Water Well Co.</i>

NAME & MAILING ADDRESS OF LANDOWNER <i>Larry McMullan</i>			
<i>Rouses MARINA RD,</i>			
<i>VANCLEAVE MS</i>			
WELL LOCATION:	SEC	TOWNSHIP	RANGE
	<i>26</i>	<i>6</i>	<i>7</i>
		<i>N</i>	<i>E</i>
DISTANCE	DIRECTION	NEAREST TOWN	
<i>4</i> Miles	<i>SE</i>	<i>VANCLEAVE</i>	
OTHER LANDMARK			
WELL PURPOSE: Home, Irrigation, Municipal, Industrial, Fish Pond, etc. <i>home</i>			

PUMP DATA		
PUMP TYPE (Circle One): Submersible, Turbine, <input checked="" type="radio"/> <i>JET</i> Flowing Well, Other (Describe) _____		
POWER TYPE (Circle One): <input checked="" type="radio"/> <i>Electric</i> , Tractor, Diesel, Gasoline, Butane, Other (Describe) _____		
Pump Capacity (GPM) <i>13</i>	No. of Stages <i>2</i>	Setting Depth <i>60</i> FT.
PUMP TEST		
Well yielded _____ GPM with a drawdown of _____ ft. after _____ hours of pumping		


WELL DATA		
Well Depth <i>130' 95'</i>	Casing Diameter (In.) <i>2"</i>	Casing Length (Ft.) <i>115'</i>
Type of Casing <i>PVC</i>	Hole Depth <i>130'</i>	Depth to Static Water Level <i>25'</i>
TYPE OF COMPLETION: (Circle One or More): <input checked="" type="checkbox"/> <i>Gravel Packed</i> , <input type="checkbox"/> Underreamed, <input type="checkbox"/> Telescoped, <input checked="" type="checkbox"/> <i>Natural Development</i> , <input type="checkbox"/> Open Hole, <input type="checkbox"/> Other (Describe) _____		
Top of Lap Pipe or Reduction in Casing		
FEET	IF TELESCOPED OR MORE THAN ONE SCREEN: USE BACK PAGE	

LOG DATA	
TYPE OF LOG RUN (Circle One): Electric, Gamma Ray, Density, Sonic, Neutron, Other (Describe) _____	
<input checked="" type="radio"/> <i>No Log Run</i>	
Name of Organization Running Log	

SCREEN DATA		
Diameter - Inches <i>2"</i>	Length - Feet <i>10'</i>	Slot Size - Inches <i>100 8</i>
Screen Type <i>PVC</i>	Depth to Bottom - Feet <i>125'</i>	

GEOLOGIC DATA (Office Use Only)			
Surface Elev.	Geologic Unit	Unit Thickness	Depth to Top
Subs. SWL	Date	Analysis	Aquifer Test
Driller's Remarks			

DESCRIPTION OF FORMATIONS ENCOUNTERED	FROM	TO
<i>White Coarse Sand</i>	<i>0</i>	<i>20'</i>
<i>Brown Clay</i>	<i>20'</i>	<i>33'</i>
<i>White Coarse Sand</i>	<i>33'</i>	<i>65'</i>
<i>Blue Clay</i>	<i>65'</i>	<i>88'</i>
<i>Gray Med. Sand</i>	<i>88'</i>	<i>130'</i>

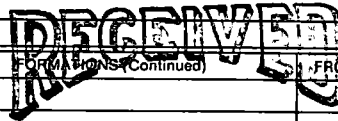

NOV 17 1988

Department of Natural Resources
Bureau of Land & Water Resources

FORMATIONS (Continued)	FROM	TO

IF MORE SPACE IS NEEDED, USE BACK

If well telescopes please sketch and show depths.

GROUND LEVEL

		X	

SECTION 26

Please indicate well location X.

ADDITIONAL INFORMATION

If more than one screen, show location of each on sketch.