

MISSISSIPPI DEPARTMENT OF NATURAL RESOURCES
Bureau of Land and Water Resources

P.O. Box 10631

Jackson, Mississippi 39209
WATER WELL DRILLERS LOG

COUNTY WELL LOCATED <i>Jackson</i>	
WELL NUMBER <i>K 7976</i>	CODED
DATE WELL COMPLETED <i>9/30/89</i>	

PERMIT NUMBER
NAME OF DRILLING FIRM <i>Coast Water Well, Inc.</i>

NAME & MAILING ADDRESS OF LANDOWNER <i>Lynn Mc Mahan</i>			
<i>1908 Scordino Rd.</i>			
<i>Vance, Ms. 39564</i>			
WELL LOCATION:	SEC	TOWNSHIP	RANGE
	<i>24</i>	<i>6</i>	<i>7</i>
DISTANCE	DIRECTION	NEAREST TOWN	
<i>3 1/2</i> Miles	<i>SE</i>	<i>Vance</i>	
OTHER LANDMARK			
WELL PURPOSE: <i>home & fish tank</i>			

PUMP DATA			
PUMP TYPE (Circle One): Submersible, Turbine, Jet, Flowing Well, Other (Describe) _____			
POWER TYPE (Circle One): Electric, Tractor, Diesel, Gasoline, Butane, Other (Describe) _____ H/P _____			
Pump Capacity (GPM)	No. of Stages	Setting Depth	FT.
<i>None</i>			
PUMP TEST <i>None flow</i>			
Well yielded _____ GPM with a drawdown of _____ ft. after _____ hours of pumping			

WELL DATA		
Well Depth <i>1357'</i>	Casing Diameter (In.) <i>2"</i>	Casing Length (Ft.) <i>1318'</i>
Type of Casing <i>PVC</i>	Hole Depth <i>1357'</i>	Depth to Static Water Level <i>Flow</i>
TYPE OF COMPLETION: (Circle One or More): Gravel Packed, Underreamed, Telescoped, Natural Development, Open Hole, Other (Describe) _____		
Top of Lap Pipe or Reduction in Casing		
FEET	IF TELESCOPED OR MORE THAN ONE SCREEN: USE BACK PAGE	

LOG DATA			
TYPE OF LOG RUN (Circle One): Electric, Gamma Ray, Density, Sonic, Neutron, Other (Describe) _____			
Name of Organization Running Log			

SCREEN DATA		
Diameter - Inches <i>2"</i>	Length - Feet <i>30'</i>	Slot Size - Inches <i>.008</i>
Screen Type <i>PVC</i>	Depth to Bottom - Feet <i>1348'</i>	


GEOLOGIC DATA (Office Use Only)			
Surface Elev.	Geologic Unit	Unit Thickness	Depth to Top
Subs. SW	Date	Analysis	Aquifer Test
Driller's Remarks <i>NOV 21 1989</i>			
Department of Natural Resources Bureau of Land & Water Resources			

DESCRIPTION OF FORMATIONS ENCOUNTERED	FROM	TO	FORMATIONS (Continued)	FROM	TO
<i>Red Clay</i>	<i>0</i>	<i>12</i>	<i>Blue Clay/Silt</i>	<i>1053</i>	<i>1084</i>
<i>Red clay sand</i>	<i>12</i>	<i>55</i>	<i>Blue Clay</i>	<i>1084</i>	<i>1182</i>
<i>White clay</i>	<i>55</i>	<i>72</i>	<i>Blue Clay/Silt</i>	<i>1182</i>	<i>1220</i>
<i>Brown fine sand</i>	<i>72</i>	<i>121</i>	<i>Gray fine sand</i>	<i>1220</i>	<i>1245</i>
<i>Blue clay</i>	<i>121</i>	<i>795</i>	<i>Blue Clay/Silt</i>	<i>1245</i>	<i>1320</i>
<i>Gray fine sand</i>	<i>795</i>	<i>817</i>	<i>Gray med. sand</i>	<i>1320</i>	<i>1348</i>
<i>Blue clay</i>	<i>817</i>	<i>922</i>	<i>Blue clay</i>	<i>1348</i>	<i>1357</i>
<i>Gray med. sand</i>	<i>922</i>	<i>944</i>			
<i>Blue clay/silt</i>	<i>944</i>	<i>968</i>			
<i>Gray fine sand</i>	<i>968</i>	<i>1012</i>			
<i>Blue clay/silt/sand</i>	<i>1012</i>	<i>1053</i>			

IF MORE SPACE IS NEEDED, USE BACK

If well telescopes please sketch and show depths.

GROUND LEVEL

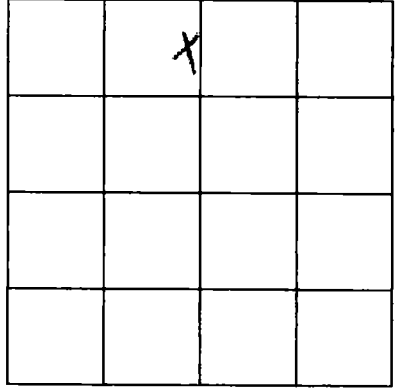

SECTION 24

Please indicate well location X.

ADDITIONAL INFORMATION

Lined area for additional information.

If more than one screen, show location of each on sketch.