

MISSISSIPPI DEPARTMENT OF NATURAL RESOURCES

Bureau of Land and Water Resources

P.O. Box 10631

Jackson, Mississippi 39209

WATER WELL DRILLERS LOG

COUNTY WELL LOCATED <i>Jackson</i>	
WELL NUMBER <i>R2993</i>	CODED
DATE WELL COMPLETED <i>12-14-89</i>	

PERMIT NUMBER
NAME OF DRILLING FIRM <i>Coast Water Well Serv</i>

NAME & MAILING ADDRESS OF LANDOWNER <i>Tommy Green</i>			
<i>Highway 57</i>			
<i>Vandeventer, Ms 39564</i>			
WELL LOCATION:	SEC	TOWNSHIP	RANGE
	<i>5</i>	<i>6 S</i>	<i>7 E</i>
DISTANCE	DIRECTION	NEAREST TOWN	
<i>2</i> Miles	<i>NW</i>	of <i>Vandeventer</i>	
OTHER LANDMARK			
WELL PURPOSE: Home, Irrigation, Municipal, Industrial, Fish Pond, etc. <i>Home</i>			

PUMP DATA		
PUMP TYPE (Circle One): Submersible, Turbine, <u>Jet</u> Flowing Well, Other (Describe) _____		
POWER TYPE (Circle One): <u>Electric</u> Tractor, Diesel, Gasoline, Butane, Other (Describe) _____ H/P _____		
Pump Capacity (GPM) <i>5</i>	No. of Stages <i>2</i>	Setting Depth _____ FT.
PUMP TEST		
Well yielded _____ GPM with a drawdown of _____ ft. after _____ hours of pumping		

WELL DATA		
Well Depth <i>317</i>	Casing Diameter (In.) <i>2"</i>	Casing Length (Ft.) <i>307</i>
Type of Casing <i>Pvc</i>	Hole Depth <i>322</i>	Depth to Static Water Level <i>74</i>
TYPE OF COMPLETION: (Circle One or More): Gravel Packed, Underreamed, Telescoped, <u>Natural Development</u> , Open Hole, Other		
Top of Lap Pipe or Reduction in Casing		
FEET IF TELESCOPED OR MORE THAN ONE SCREEN: USE BACK PAGE		

LOG DATA	
TYPE OF LOG RUN (Circle One): Electric, Gamma Ray, Density, Sonic, Neutron, Other (Describe) _____	
Name of Organization Running Log	

SCREEN DATA		
Diameter - Inches <i>2"</i>	Length - Feet <i>10</i>	Slot Size - Inches <i>.008</i>
Screen Type <i>Pvc</i>	Depth to Bottom - Feet <i>317</i>	


GEOLOGIC DATA (Office Use Only)			
Surface Elev.	Geologic Unit	Unit Thickness	Depth to Top
Subs. SWL	Date	Analysis	Hydro. Test
RECEIVED			
Driller's Remarks			
JAN 09 1990			
Department of Natural Resources Bureau of Land & Water Resources			

DESCRIPTION OF FORMATIONS ENCOUNTERED	FROM	TO	FORMATIONS (Continued)	FROM	TO
<i>Shallow Clay</i>	<i>0</i>	<i>12</i>	<i>Green Coarse Sand</i>	<i>180</i>	<i>197</i>
<i>Red Coarse Sand</i>	<i>12</i>	<i>20</i>	<i>Dry Clay w/</i>		
<i>Light Clay</i>	<i>20</i>	<i>22</i>	<i>1st thick of sand</i>	<i>197</i>	<i>232</i>
<i>White Clay</i>	<i>22</i>	<i>38</i>	<i>pressure that 5/1 clay</i>	<i>232</i>	<i>255</i>
<i>Blue Clay</i>	<i>38</i>	<i>60</i>	<i>dry med sand</i>	<i>255</i>	<i>279</i>
<i>White Clay w/ 5/1 of</i>			<i>dry coarse sand</i>	<i>279</i>	<i>320</i>
<i>Sept 100</i>	<i>60</i>	<i>85</i>	<i>Blue Clay</i>	<i>320</i>	<i>322</i>
<i>Brown Med. Sand</i>	<i>85</i>	<i>105</i>			
<i>Brown Coarse Sand</i>	<i>105</i>	<i>116</i>			
<i>Blue Clay w/ thick</i>					
<i>of sand</i>	<i>116</i>	<i>180</i>			

IF MORE SPACE IS NEEDED, USE BACK

If well telescopes please sketch and show depths.

GROUND LEVEL

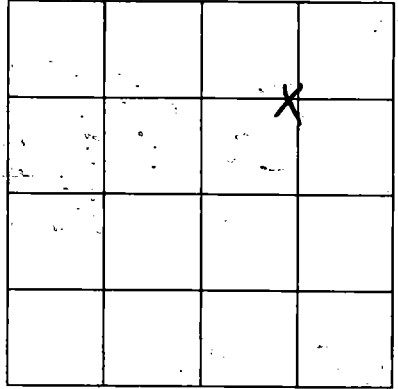

SECTION 5

Please indicate well location X.

ADDITIONAL INFORMATION

If more than one screen,
show location of each on sketch.