

# MISSISSIPPI DEPARTMENT OF NATURAL RESOURCES

Bureau of Land and Water Resources

P.O. Box 10631

Jackson, Mississippi 39209

WATER WELL DRILLERS LOG

COUNTY WELL LOCATED	
Jackson	
WELL NUMBER K2300	CODED
2-12-90	
DATE WELL COMPLETED	

PERMIT NUMBER 0408
NAME OF DRILLING FIRM Fryfoyle Well Svc.
hucedale MS 39452

NAME & MAILING ADDRESS OF LANDOWNER		
Keith Howell		
Rt 6 Box 553		
Hucedale MS 39452		
WELL LOCATION:	SEC	TOWNSHIP RANGE
	7	T6 N 0 R 7 E W
DISTANCE	DIRECTION	NEAREST TOWN
2 Miles	West	of Vandevore
OTHER LANDMARK		
On Jim Ramsey Rd		
WELL PURPOSE: Home, Irrigation, Municipal, Industrial, Fish Pond, etc.		
Across from Honey Creek		

PUMP DATA		
PUMP TYPE (Circle One):		
Submersible,	Turbine,	<u>Jet</u> Flowing Well,
Other (Describe) _____		
POWER TYPE (Circle One):		
Electric,	Tractor,	Diesel, Gasoline, Butane,
Other (Describe) _____ H/P _____		
Pump Capacity (GPM)	No. of Stages	Setting Depth
10	2	80 FT.
PUMP TEST		
Well yielded _____ 10 GPM with		
a drawdown of <u>1/2</u> ft.		
after _____ hours of pumping		

WELL DATA		
Well Depth	Casing Diameter (In.)	Casing Length (Ft.)
200'	2"	190
Type of Casing	Hole Depth	Depth to Static Water Level
PVC	200	55'
TYPE OF COMPLETION: (Circle One or More):		
Gravel Packed,	Underreamed,	Telescoped,
Natural Development,	Open Hole,	Other
(Describe) <u>air lift</u>		
Top of Lap Pipe or Reduction in Casing		
FEET IF TELESCOPED OR MORE THAN ONE SCREEN: USE BACK PAGE		

LOG DATA	
TYPE OF LOG RUN (Circle One):	
Electric, Gamma Ray, Density, Sonic, Neutron,	No Log Run,
Other (Describe) _____	
Name of Organization Running Log	

SCREEN DATA		
Diameter - Inches	Length - Feet	Slot Size - Inches
2"	5' w/ 5's	#6 #8
Screen Type	Depth to Bottom - Feet	
Whip + Savel	200'	

GEOLOGIC DATA (Office Use Only)			
Surface Elev.	Geologic Unit	Unit Thickness	Depth to Top
Subs. SWL	Date	Analysis	Aquifer Test


Driller's Remarks

DESCRIPTION OF FORMATIONS ENCOUNTERED	FROM	TO	FORMATIONS (Continued)	FROM	TO
top Sand	0	5	<div style="font-size: 2em; font-weight: bold; opacity: 0.5;">RECEIVED</div> <div style="font-size: 1.5em; font-weight: bold; margin-top: 10px;">MAR 16 1990</div> <div style="font-size: 0.8em; font-weight: bold; margin-top: 10px;">Department of Natural Resources Bureau of Land &amp; Water Resources</div>		
Sand +	5	20			
Streaky sand + clay	20	40			
clay	40	60			
Brown Sand	60	80			
clay	80	100			
11	100	140			
Streaky Sand + clay	140	160			
Fine Blue Sand	160	180			
Med Blue Sand	180	200			

IF MORE SPACE IS NEEDED, USE BACK

If well telescopes please  
sketch and show depths.

GROUND LEVEL

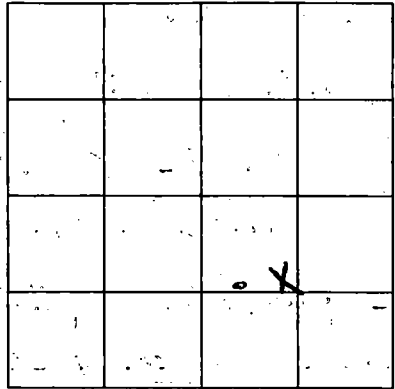

SECTION 7

Please indicate well location X.

ADDITIONAL INFORMATION

If more than one screen,  
show location of each on sketch.