

MISSISSIPPI DEPARTMENT OF NATURAL RESOURCES

Bureau of Land and Water Resources

P.O. Box 10631

Jackson, Mississippi 39209

WATER WELL DRILLERS LOG

COUNTY WELL LOCATED <i>Jackson</i>	
WELL NUMBER <i>R 02315</i>	CODED
DATE WELL COMPLETED <i>8/21/90</i>	

PERMIT NUMBER
NAME OF DRILLING FIRM <i>Coast Water Well, Inc.</i>

NAME & MAILING ADDRESS OF LANDOWNER <i>Christopher Seals</i>			
<i>Water Oaks Rd</i>			
<i>Vandeventer, Ms</i>			
WELL LOCATION:	SEC <i>22</i>	TOWNSHIP <i>6^N 7^W</i>	RANGE
DISTANCE <i>3</i> Miles	DIRECTION <i>S</i>	NEAREST TOWN <i>Vandeventer</i>	
OTHER LANDMARK			
WELL PURPOSE <input checked="" type="checkbox"/> Home; <input type="checkbox"/> Irrigation, <input type="checkbox"/> Municipal, <input type="checkbox"/> Industrial, <input type="checkbox"/> Fish Pond, etc.			

PUMP DATA		
PUMP TYPE (Circle One): Submersible, Turbine, <input checked="" type="radio"/> <i>Jet</i> Flowing Well, Other (Describe) _____		
POWER TYPE (Circle One): <input checked="" type="radio"/> <i>Electric</i> , Tractor, Diesel, Gasoline, Butane, Other (Describe) _____ H/P _____		
Pump Capacity (GPM) <i>10</i>	No. of Stages <i>2</i>	Setting Depth FT.
PUMP TEST		
Well yielded _____ GPM with a drawdown of _____ ft. after _____ hours of pumping		

WELL DATA		
Well Depth <i>482'</i>	Casing Diameter (In.) <i>2"</i>	Casing Length (Ft.) <i>467</i>
Type of Casing <i>PVC</i>	Hole Depth <i>482</i>	Depth to Static Water Level <i>451</i>
TYPE OF COMPLETION: (Circle One or More): <input checked="" type="checkbox"/> Gravel Packed, <input type="checkbox"/> Underreamed, <input type="checkbox"/> Telescoped, <input checked="" type="checkbox"/> Natural Development, <input type="checkbox"/> Open Hole, <input type="checkbox"/> Other		
Top of Lap Pipe or Reduction in Casing FEET <input type="checkbox"/> IF TELESCOPED OR MORE THAN ONE SCREEN: USE BACK PAGE		


LOG DATA	
TYPE OF LOG RUN (Circle One): Electric, Gamma Ray, Density, Sonic, Neutron, Other (Describe) _____ <input checked="" type="radio"/> <i>No Log Run</i>	
Name of Organization Running Log	

SCREEN DATA		
Diameter - Inches <i>2'</i>	Length - Feet <i>10'</i>	Slot Size - Inches <i>.008</i>
Screen Type <i>PVC</i>	Depth to Bottom - Feet <i>477'</i>	

GEOLOGIC DATA (Office Use Only)			
Surface Elev.	Geologic Unit	Unit Thickness	Depth to Top
Subs. SWL	Date	Analysis	Aquifer Test
Driller's Remarks			

DESCRIPTION OF FORMATIONS ENCOUNTERED	FROM	TO
<i>Top soil</i>	<i>0</i>	<i>2</i>
<i>Yellow clay</i>	<i>2</i>	<i>15</i>
<i>Med. sand</i>	<i>15</i>	<i>50</i>
<i>Gray Clay</i>	<i>50</i>	<i>75</i>
<i>Coarse sand</i>	<i>75</i>	<i>130</i>
<i>Blue Clay / sand</i>	<i>130</i>	<i>460</i>
<i>Coarse sand</i>	<i>460</i>	<i>478</i>

FORMATIONS (Continued)	FROM	TO

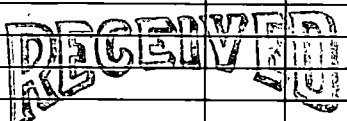

OCT 15 1990

Department of Natural Resources
Bureau of Land & Water Resources

IF MORE SPACE IS NEEDED, USE BACK

If well telescopes please
sketch and show depths.

GROUND LEVEL

			X

SECTION 22

Please indicate well location X.

ADDITIONAL INFORMATION

If more than one screen,
show location of each on sketch.