

# MISSISSIPPI DEPARTMENT OF NATURAL RESOURCES

Bureau of Land and Water Resources

COUNTY WELL LOCATED <i>Jackson</i>	
WELL NUMBER <i>12352</i>	CODER
DATE WELL COMPLETED <i>7-16-90</i>	

PERMIT NUMBER
NAME OF DRILLING FIRM <i>Coast Water Wells, Inc.</i>

P.O. Box 10631  
Jackson, Mississippi 39209  
**WATER WELL DRILLERS LOG**

NAME & MAILING ADDRESS OF LANDOWNER <i>Rudolph Gibson</i>			
<i>Johns Bayou Rd</i>			
<i>Vancleave, Mo. 39564</i>			
WELL LOCATION:	SEC	TOWNSHIP	RANGE
	<i>25</i>	<i>6</i>	<i>7</i>
DISTANCE	DIRECTION	NEAREST TOWN	
<i>3 1/2</i> Miles	<i>SE</i>	<i>of Vancleave</i>	
OTHER LANDMARK			
WELL PURPOSE: <input checked="" type="checkbox"/> Home Irrigation, <input type="checkbox"/> Municipal, <input type="checkbox"/> Industrial, <input type="checkbox"/> Fish Pond, etc.			

<b>PUMP DATA</b>		
PUMP TYPE (Circle One): Submersible, Turbine, <input checked="" type="radio"/> Jet <input type="radio"/> Flowing Well, Other (Describe) _____		
POWER TYPE (Circle One): <input checked="" type="radio"/> Electric <input type="radio"/> Tractor, <input type="radio"/> Diesel, <input type="radio"/> Gasoline, <input type="radio"/> Butane, Other (Describe) _____ H/P _____		
Pump Capacity (GPM) <i>13</i>	No. of Stages <i>2</i>	Setting Depth <i>—</i> FT.
PUMP TEST		
Well yielded _____ GPM with a drawdown of _____ ft. after _____ hours of pumping		

<b>WELL DATA</b>		
Well Depth <i>145</i>	Casing Diameter (In.) <i>2"</i>	Casing Length (Ft.) <i>135</i>
Type of Casing <i>PVC</i>	Hole Depth <i>150'</i>	Depth to Static Water Level <i>20'</i>
TYPE OF COMPLETION: (Circle One or More): <input type="checkbox"/> Gravel Packed, <input type="checkbox"/> Underreamed, <input type="checkbox"/> Telescoped, <input type="checkbox"/> Natural Development, <input type="checkbox"/> Open Hole, <input type="checkbox"/> Other (Describe) _____		
Top of Lap Pipe or Reduction in Casing		
FEET <input type="checkbox"/> IF TELESCOPED OR MORE THAN ONE SCREEN: USE BACK PAGE		

<b>LOG DATA</b>	
TYPE OF LOG RUN (Circle One): Electric, Gamma Ray, Density, Sonic, Neutron, Other (Describe) _____	
Name of Organization Running Log <i>No Log Run</i>	

<b>SCREEN DATA</b>		
Diameter - Inches <i>2"</i>	Length - Feet <i>10'</i>	Slot Size - Inches <i>.008</i>
Screen Type <i>PVC</i>	Depth to Bottom - Feet <i>145</i>	

<b>GEOLOGIC DATA (Office Use Only)</b>			
Surface Elev.	Geologic Unit	Unit Thickness	Depth to Top
Subs. SWL	Date	Analysis	Aquifer Test
Driller's Remarks			


DESCRIPTION OF FORMATIONS ENCOUNTERED	FROM	TO
<i>Top soil</i>	<i>0</i>	<i>2'</i>
<i>Yellow Clay</i>	<i>2</i>	<i>25</i>
<i>Blue Clay</i>	<i>25</i>	<i>80</i>
<i>Med. Sand</i>	<i>80</i>	<i>105</i>
<i>Blue Clay</i>	<i>105</i>	<i>120</i>
<i>Med. to coarse sand</i>	<i>120</i>	<i>150</i>

FORMATIONS CONTINUED	FROM	TO
RECEIVED		
JAN 11 1991		
Dept. of Environmental Quality Bureau of Land & Water Resources		
IF MORE SPACE IS NEEDED, USE BACK		

*Johnson*

If well telescopes please sketch and show depths.

GROUND LEVEL

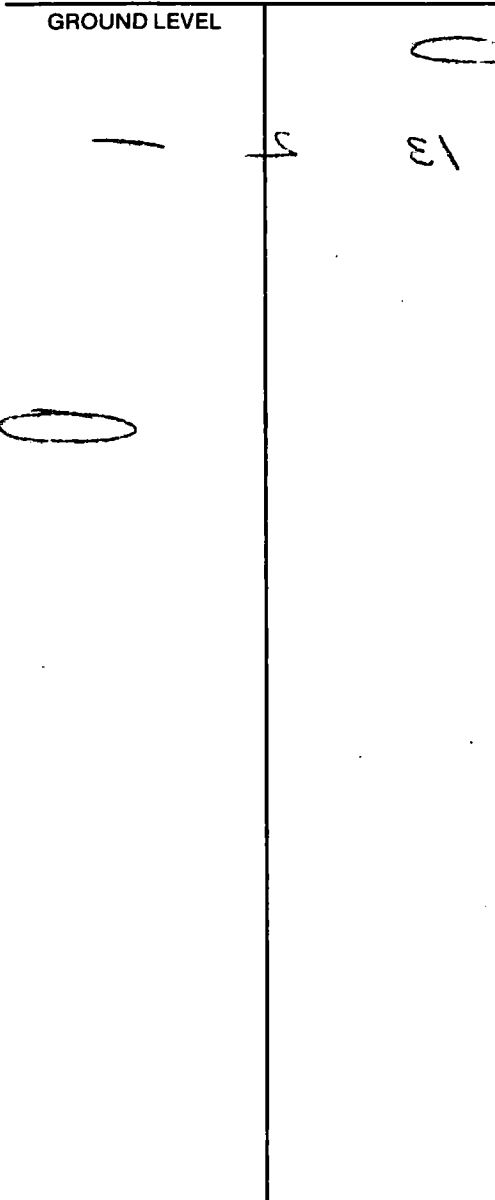

<i>13</i>	<i>22</i>	<i>25</i>	<i>28</i>
<i>22</i>	<i>25</i>	<i>28</i>	<i>31</i>
<i>31</i>	<i>34</i>	<i>37</i>	<i>40</i>
<i>43</i>	<i>46</i>	<i>49</i>	<i>52</i>
<i>55</i>	<i>58</i>	<i>61</i>	<i>64</i>
<i>67</i>	<i>70</i>	<i>73</i>	<i>76</i>
<i>79</i>	<i>82</i>	<i>85</i>	<i>88</i>
<i>91</i>	<i>94</i>	<i>97</i>	<i>100</i>

SECTION 25

Please indicate well location X.

ADDITIONAL INFORMATION

*[Lined area for additional information]*

If more than one screen, show location of each on sketch.