

MISSISSIPPI DEPARTMENT OF ENVIRONMENTAL QUALITY
Bureau of Land and Water Resources

P. O. Box 10631
Jackson, MS 39289-0631
WATER WELL DRILLERS LOG

COUNTY WELL LOCATED <i>Jackson</i>
WELL NUMBER (CODED) <i>R7385</i>
DATE WELL COMPLETED <i>12-28-90</i>

PERMIT NUMBER
NAME OF DRILLING FIRM <i>Coast Water Well Serv.</i>

NAME & MAILING ADDRESS OF LANDOWNER <i>Kenneth Sellers</i>			
<i>Humphrey Rd.</i>			
<i>Vandeventer, MS - 39564</i>			
WELL LOCATION:	SEC	TOWNSHIP	RANGE
	<i>20</i>	<i>6</i>	<i>7^W</i>
DISTANCE	DIRECTION	NEAREST TOWN	
<i>2</i> Miles	<i>S</i>	<i>Vandeventer</i>	
OTHER LANDMARK			
WELL PURPOSE <input checked="" type="checkbox"/> Home Irrigation, Municipal, Industrial, Fish Pond, etc.			

PUMP DATA		
PUMP TYPE (Circle One): Submersible, Turbine, Jet, Flowing Well, Other (Describe) _____		
POWER TYPE (Circle One): Electric, Tractor, Diesel, Gasoline, Butane, Other (Describe) _____ H/P _____		
Pump Capacity (GPM)	No. of Stages	Setting Depth FT.
PUMP TEST		
Well yielded _____ GPM with a drawdown of _____ ft. after _____ hours of pumping		

WELL DATA		
Well Depth <i>380</i>	Casing Diameter (In.) <i>2"</i>	Casing Length (Ft.) <i>370</i>
Type of Casing <i>PVC</i>	Hole Depth <i>386'</i>	Depth to Static Water Level <i>84'</i>
TYPE OF COMPLETION: (Circle One or More): Gravel Packed, Underreamed, Telescoped, Natural Development, Open Hole, Other (Describe) _____		
Top of Lap Pipe or Reduction in Casing FEET IF TELESCOPED OR MORE THAN ONE SCREEN: USE BACK PAGE		

LOG DATA	
TYPE OF LOG RUN (Circle One): Electric, Gamma Ray, Density, Sonic, Neutron, Other (Describe) _____ No Log Run	
Name of Organization Running Log	

SCREEN DATA		
Diameter - Inches <i>2"</i>	Length - Feet <i>10'</i>	Slot Size - Inches <i>.008</i>
Screen Type <i>PVC</i>	Depth to Bottom - Feet <i>380'</i>	

GEOLOGIC DATA (Office Use Only)			
Surface Elev.	Geologic Unit	Unit Thickness	Depth to Top
Subs. SWL	Date	Analysis	Aquifer Test
Driller's Remarks			

DESCRIPTION OF FORMATIONS ENCOUNTERED	FROM	TO	FORMATION	DEPTH	TO
<i>Top soil</i>	<i>0</i>	<i>2</i>			
<i>Yellow Clay</i>	<i>2</i>	<i>12</i>			
<i>Coarse sand</i>	<i>12</i>	<i>20</i>			
<i>Grey Clay</i>	<i>20</i>	<i>90</i>			
<i>Coarse sand</i>	<i>90</i>	<i>180</i>			
<i>Blue Clay</i>	<i>180</i>	<i>320</i>			
<i>Coarse sand</i>	<i>320</i>	<i>380</i>			

RECEIVED


JAN 11 1991

Dept. of Environmental Quality
Bureau of Land & Water Resources

IF MORE SPACE IS NEEDED, USE BACK

If well telescopes please sketch and show depths.

GROUND LEVEL

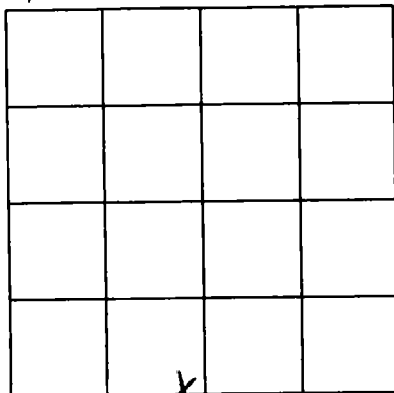

SECTION 20

Please indicate well location X.

ADDITIONAL INFORMATION

Lined area for additional information.

If more than one screen, show location of each on sketch.