

MISSISSIPPI DEPARTMENT OF ENVIRONMENTAL QUALITY
Bureau of Land and Water Resources

P. O. Box 10631
Jackson, MS 39289-0631
WATER WELL DRILLERS LOG

COUNTY WELL LOCATED <i>Jackson</i>	
WELL NUMBER <i>R-2351</i>	CODED
DATE WELL COMPLETED <i>1-23-92</i>	

PERMIT NUMBER
NAME OF DRILLING FIRM <i>Const Water Well Serv. Inc.</i>

NAME & MAILING ADDRESS OF LANDOWNER <i>Lennie Forehand</i>			
WELL LOCATION: SEC <u>10</u> TOWNSHIP <u>N 6 S 7 E</u> RANGE <u>7 W</u>			
DISTANCE	DIRECTION	NEAREST TOWN	
<u>1</u> Miles	<u>East</u>	<u>Hamden</u>	
OTHER LANDMARK			
WELL PURPOSE: <u>Home</u> , Irrigation, Municipal, Industrial, Fish Pond, etc.			

PUMP DATA		
PUMP TYPE (Circle One): Submersible, Turbine, Jet, Flowing Well, Other (Describe) _____		
POWER TYPE (Circle One): Electric, Tractor, Diesel, Gasoline, Butane, Other (Describe) _____ H/P _____		
Pump Capacity (GPM)	No. of Stages	Setting Depth _____ FT.
PUMP TEST		
Well yielded _____ GPM with		_____ ft.
a drawdown of _____ ft.		
after _____ hours of pumping		

WELL DATA		
Well Depth <i>110'</i>	Casing Diameter (In.) <i>2"</i>	Casing Length (Ft.) <i>100'</i>
Type of Casing <i>PVC</i>	Hole Depth <i>110'</i>	Depth to Static Water Level <i>45'</i>
TYPE OF COMPLETION: (Circle One or More): Gravel Packed, Underreamed, Telescoped, Natural Development, Open Hole, Other (Describe) _____		
Top of Lap Pipe or Reduction in Casing		
FEET	IF TELESCOPED OR MORE THAN ONE SCREEN: USE BACK PAGE	

LOG DATA	
TYPE OF LOG RUN (Circle One): Electric, Gamma Ray, Density, Sonic, Neutron, Other (Describe) _____	
Name of Organization Running Log	

SCREEN DATA		
Diameter - Inches <i>2"</i>	Length - Feet <i>10'</i>	Slot Size - Inches <i>.008</i>
Screen Type <i>PVC</i>	Depth to Bottom - Feet <i>110'</i>	


GEOLOGIC DATA (Office Use Only)			
Surface Elev.	Geologic Unit	Unit Thickness	Depth to Top
Subs. SWL	Date	Analysis	Aquifer Test
Driller's Remarks			

DESCRIPTION OF FORMATIONS ENCOUNTERED	FROM	TO
<i>Top soil</i>	<i>0</i>	<i>5</i>
<i>Coarse sand</i>	<i>5</i>	<i>16</i>
<i>Red/gray clay</i>	<i>16</i>	<i>60</i>
<i>Coarse sand</i>	<i>60</i>	<i>110</i>

FORMATIONS (Continued)	FROM	TO
RECEIVED		
MAR 23 1992		
Dept. of Environmental Quality Bureau of Land & Water Resources		
IF MORE SPACE IS NEEDED, USE BACK		

If well telescopes please sketch and show depths.

GROUND LEVEL

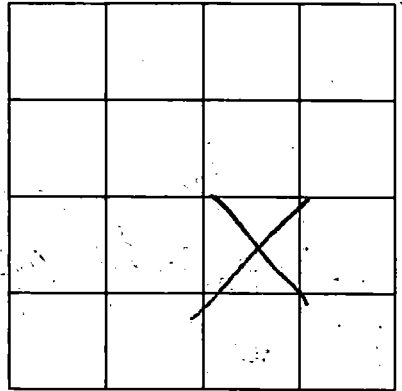


SECTION _____

Please indicate well location X.

ADDITIONAL INFORMATION

Lined area for providing additional information.

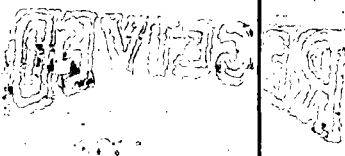

If more than one screen, show location of each on sketch.