


If well telescopes please sketch and show depths.

GROUND LEVEL

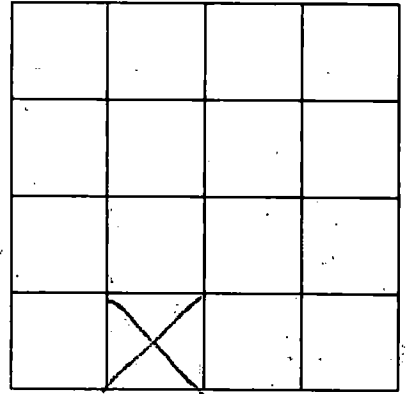

SECTION _____

Please indicate well location X.

ADDITIONAL INFORMATION

RECEIVED

NOV 14 1953

U.S. GEOLOGICAL SURVEY
WASHINGTON, D.C.

If more than one screen,
show location of each on sketch.