

MISSISSIPPI DEPARTMENT OF ENVIRONMENTAL QUALITY
Bureau of Land and Water Resources

P. O. Box 10631
Jackson, MS 39289-0631
WATER WELL DRILLERS LOG

COUNTY WELL LOCATED
Jackson

WELL NUMBER CODED
K7358

DATE WELL COMPLETED
5-28-92

PERMIT NUMBER

NAME OF DRILLING FIRM
Coast Water Well Ser Inc.

NAME & MAILING ADDRESS OF LANDOWNER
Clinton Fulton

WELL LOCATION: SEC 20 TOWNSHIP 6 RANGE 7
N W

DISTANCE 2 Miles S of Clanchar

OTHER LANDMARK

WELL PURPOSE: Home (Irrigation) Municipal, Industrial, Fish Pond, etc.

PUMP DATA

PUMP TYPE (Circle One):
Submersible, Turbine, Jet Flowing Well,
Other (Describe)

POWER TYPE (Circle One):
Electric Tractor, Diesel, Gasoline, Butane,
Other (Describe) H/P

| | | |
|---------------------------------|---------------------------|--------------------------------------|
| Pump Capacity (GPM) <u>8</u> | No. of Stages <u>2</u> | Setting Depth <u> </u> FT. |
|---------------------------------|---------------------------|--------------------------------------|

PUMP TEST

Well yielded GPM with
a drawdown of ft.
after hours of pumping

WELL DATA

| | | |
|------------------------------|------------------------------------|---|
| Well Depth <u>150'</u> | Casing Diameter (In.) <u>2"</u> | Casing Length (Ft.) <u>140'</u> |
| Type of Casing <u>PVC</u> | Hole Depth <u>150'</u> | Depth to Static Water Level <u>48'</u> |

TYPE OF COMPLETION: (Circle One or More):
Gravel Packed, Underreamed, Telescoped,
Natural Development, Open Hole, Other

Top of Lap Pipe or Reduction in Casing
 FEET

IF TELESCOPED OR MORE THAN ONE SCREEN: USE BACK PAGE

LOG DATA

TYPE OF LOG RUN (Circle One): No Log Run
Electric, Gamma Ray, Density, Sonic, Neutron,
Other (Describe)

Name of Organization Running Log

SCREEN DATA

| | | |
|--------------------------------|---------------------------------------|-----------------------------------|
| Diameter - Inches <u>2"</u> | Length - Feet <u>10'</u> | Slot Size - Inches <u>.008</u> |
| Screen Type <u>PVC</u> | Depth to Bottom - Feet <u>150'</u> | |

GEOLOGIC DATA (Office Use Only)

| | | | |
|---------------|---------------|----------------|--------------|
| Surface Elev. | Geologic Unit | Unit Thickness | Depth to Top |
| Subs. SWL | Date | Analysis | Aquifer Test |

Driller's Remarks

| DESCRIPTION OF FORMATIONS ENCOUNTERED | FROM | TO |
|---------------------------------------|------------|------------|
| <i>top soil</i> | <i>0</i> | <i>2</i> |
| <i>yellow clay</i> | <i>2</i> | <i>20</i> |
| <i>(pump) sand & clay</i> | <i>20</i> | <i>40</i> |
| <i>yellow/gray sand</i> | <i>40</i> | <i>120</i> |
| <i>coarse sand</i> | <i>120</i> | <i>150</i> |
| | | |
| | | |
| | | |
| | | |

RECEIVED


OCT 07 1992

Dept. of Environmental Quality
Bureau of Land & Water Resources

IF MORE SPACE IS NEEDED, USE BACK

If well telescopes please sketch and show depths.

GROUND LEVEL

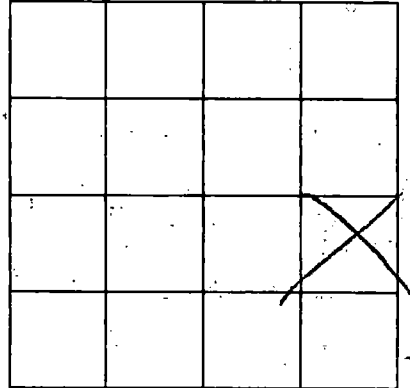

SECTION _____

Please indicate well location X.

ADDITIONAL INFORMATION

Multiple horizontal lines for writing additional information.

RECEIVED

APR 11 1968

UNITED STATES DEPARTMENT OF THE INTERIOR
BUREAU OF LAND MANAGEMENT

If more than one screen, show location of each on sketch.