

MISSISSIPPI DEPARTMENT OF ENVIRONMENTAL QUALITY
Bureau of Land and Water Resources

P. O. Box 10631
Jackson, MS 39289-0631
WATER WELL DRILLERS LOG

COUNTY WELL LOCATED <i>Jackson</i>	
WELL NUMBER <i>K 2359</i>	CODED
DATE WELL COMPLETED <i>6-16-92</i>	

PERMIT NUMBER
NAME OF DRILLING FIRM <i>Coast Water Well Services Inc.</i>

NAME & MAILING ADDRESS OF LANDOWNER <i>Havens Carter</i>			
WELL LOCATION: SEC <u>23</u> TOWNSHIP <u>6 N</u> RANGE <u>7 E</u>			
DISTANCE	DIRECTION	NEAREST TOWN	
<u>2 1/2</u> Miles	<u>SE</u>	of <u>Vandevue</u>	
OTHER LANDMARK			
WELL PURPOSE: Home Irrigation, Municipal, Industrial, Fish Pond, etc.			

PUMP DATA		
PUMP TYPE (Circle One): Submersible, Turbine, <u>Jet</u> Flowing Well, Other (Describe) _____		
POWER TYPE (Circle One): <u>Electric</u> , Tractor, Diesel, Gasoline, Butane, Other (Describe) _____ H/P <u>1/2</u>		
Pump Capacity (GPM) <u>6</u>	No. of Stages <u>1</u>	Setting Depth <u> </u> FT.
PUMP TEST		
Well yielded _____ GPM with a drawdown of _____ ft. after _____ hours of pumping		

WELL DATA		
Well Depth <u>45'</u>	Casing Diameter (In.) <u>2 1/2</u>	Casing Length (Ft.) <u>40'</u>
Type of Casing <u>PVC</u>	Hole Depth <u>45'</u>	Depth to Static Water Level <u>18'</u>
TYPE OF COMPLETION: (Circle One or More): <u>Gravel Paiked</u> , Underreamed, Telescoped, <u>Natural Development</u> , Open Hole, Other		
Top of Lap Pipe or Reduction in Casing FEET <u> </u> IF TELESCOPED OR MORE THAN ONE SCREEN: USE BACK PAGE		

LOG DATA	
TYPE OF LOG RUN (Circle One): Electric, Gamma Ray, Density, <u>No-Log Run</u> , Soaic, Neutron, Other (Describe) _____	
Name of Organization Running Log	

SCREEN DATA		
Diameter - Inches <u>2"</u>	Length - Feet <u>51</u>	Slot Size - Inches <u>.008</u>
Screen Type <u>PVC</u>	Depth to Bottom - Feet <u>45'</u>	

GEOLOGIC DATA (Office Use Only)			
Surface Elev.	Geologic Unit	Unit Thickness	Depth to Top
Subs. SWL	Date	Analysis	Aquifer Test

Driller's Remarks

DESCRIPTION OF FORMATIONS ENCOUNTERED	FROM	TO
<i>topsoil</i>	<i>0</i>	<i>2</i>
<i>yellow clay</i>	<i>2</i>	<i>20</i>
<i>coarse sand</i>	<i>20</i>	<i>45</i>

RECEIVED


OCT 07 1992

Dept. of Environmental Quality
Bureau of Land & Water Resources

IF MORE SPACE IS NEEDED, USE BACK

If well telescopes please sketch and show depths.

GROUND LEVEL

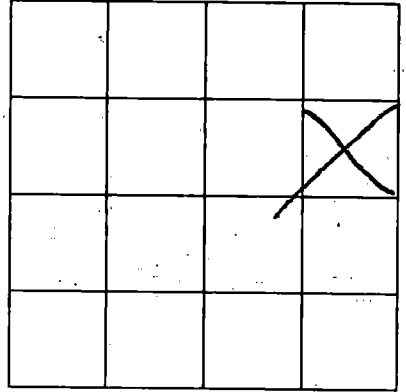

SECTION _____

Please indicate well location X.

ADDITIONAL INFORMATION

DEVIATION

SPOT TO

When telescopes are to be used
show location of each on sketch.

If more than one screen,
show location of each on sketch.