

**MISSISSIPPI DEPARTMENT OF ENVIRONMENTAL QUALITY**  
Bureau of Land and Water Resources

P. O. Box 10631  
Jackson, MS 39289-0631  
**WATER WELL DRILLERS LOG**

COUNTY WELL LOCATED <i>Jackson</i>
WELL NUMBER CODED <i>K 2861</i>
DATE WELL COMPLETED <i>4-30-92</i>

PERMIT NUMBER
NAME OF DRILLING FIRM <i>Coast Water Well Dr.</i>

NAME & MAILING ADDRESS OF LANDOWNER <i>Bob Balgi</i>		
WELL LOCATION: SEC TOWNSHIP RANGE <i>20 6 N 7 E</i>		
DISTANCE DIRECTION NEAREST TOWN <i>2 Miles S of Vancleave</i>		
OTHER LANDMARK		
WELL PURPOSE: <input checked="" type="checkbox"/> Home <input type="checkbox"/> Irrigation, Municipal, Industrial, Fish Pond, etc.		

<b>PUMP DATA</b>		
PUMP TYPE (Circle One): <del>Submersible</del> Turbine, <input checked="" type="radio"/> Jet <input type="radio"/> Flowing Well, Other (Describe) _____		
POWER TYPE (Circle One): Electric, <input checked="" type="radio"/> Tractor, Diesel, Gasoline, Butane, Other (Describe) _____ H/P <i>2</i>		
Pump Capacity (GPM) <i>9</i>	No. of Stages <i>3</i>	Setting Depth _____ FT.
PUMP TEST Well yielded _____ GPM with a drawdown of _____ ft. after _____ hours of pumping		

<b>WELL DATA</b>		
Well Depth <i>385'</i>	Casing Diameter (In.) <i>2" 4"</i>	Casing Length (Ft.) <i>200' 42' 200'</i>
Type of Casing <i>PVC</i>	Hole Depth <i>385'</i>	Depth to Static Water Level <i>70'</i>
TYPE OF COMPLETION: (Circle One or More): <input checked="" type="checkbox"/> Gravel Packed <input type="checkbox"/> Underreamed, <input type="checkbox"/> Telescoped, <input checked="" type="checkbox"/> Natural Development <input type="checkbox"/> Open Hole, <input type="checkbox"/> Other		
Top of Lap Pipe or Reduction in Casing _____ FEET		
IF TELESCOPED OR MORE THAN ONE SCREEN: USE BACK PAGE		

<b>LOG DATA</b>	
SPE OF LOG RUN (Circle One): <input checked="" type="radio"/> No Log Run, <input type="radio"/> Electric, Gamma Ray, Density, Sonic, Neutron, Other (Describe) _____	
Name of Organization Running Log	

<b>SCREEN DATA</b>		
Diameter - Inches <i>2"</i>	Length - Feet <i>20'</i>	Slot Size - Inches <i>1008</i>
Screen Type <i>PVC</i>	Depth to Bottom - Feet <i>365'</i>	


<b>GEOLOGIC DATA (Office Use Only)</b>			
Surface Elev.	Geologic Unit	Unit Thickness	Depth to Top
Subs. SWL	Date	Analysis	Aquifer Test
Driller's Remarks			

DESCRIPTION OF FORMATIONS ENCOUNTERED	FROM	TO
<i>Top soil</i>	<i>0</i>	<i>2</i>
<i>yellow pink clay</i>	<i>2</i>	<i>90</i>
<i>Coarse sand</i>	<i>90</i>	<i>178</i>
<i>Blue clay s of sand</i>	<i>178</i>	<i>320</i>
<i>Coarse sand</i>	<i>320</i>	<i>368</i>
<i>fine sand</i>	<i>368</i>	<i>385</i>

<b>RECEIVED</b>	
OCT 07 1992	
Dept. of Environmental Quality Bureau of Land & Water Resources	
IF MORE SPACE IS NEEDED, USE BACK	

If well telescopes please sketch and show depths.

GROUND LEVEL

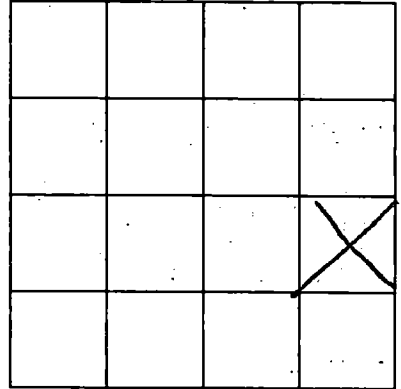

SECTION \_\_\_\_\_

-Please indicate well location X.

ADDITIONAL INFORMATION

RECEIVED

NOV 14 1968

U.S. DEPARTMENT OF THE INTERIOR  
BUREAU OF LAND MANAGEMENT

If more than one screen,  
show location of each on sketch.