

MISSISSIPPI DEPARTMENT OF ENVIRONMENTAL QUALITY
Bureau of Land and Water Resources

P. O. Box 10631
Jackson, MS 39289-0631
WATER WELL DRILLERS LOG

COUNTY WELL LOCATED <i>Jackson</i>		PERMIT NUMBER
WELL NUMBER <i>K 2362</i>	CODED	NAME OF DRILLING FIRM <i>Coast Water Well Serv Inc.</i>
DATE WELL COMPLETED <i>8-18-92</i>		

NAME & MAILING ADDRESS OF LANDOWNER
Louis Bond

WELL LOCATION: SEC 27 TOWNSHIP 6 N RANGE 7 E

DISTANCE 4 Miles DIRECTION SE of NEAREST TOWN Thorsdale

OTHER LANDMARK

WELL PURPOSE Home Irrigation, Municipal, Industrial, Fish Pond, etc.

PUMP DATA

PUMP TYPE (Circle One):
Submersible, Turbine, Jet, Flowing Well,
Other (Describe) _____

POWER TYPE (Circle One):
 Electric, Tractor, Diesel, Gasoline, Butane,
Other (Describe) _____ H/P 1

Pump Capacity (GPM) 9 No. of Stages 2 Setting Depth _____ FT.

PUMP TEST
Well yielded _____ GPM with
a drawdown of _____ ft.
after _____ hours of pumping

WELL DATA

Well Depth <i>495'</i>	Casing Diameter (In.) <i>2"</i>	Casing Length (Ft.) <i>482'</i>
Type of Casing <i>PVC</i>	Hole Depth <i>495'</i>	Depth to Static Water Level <i>32'</i>

TYPE OF COMPLETION: (Circle One or More):
 Gravel Packed, Underreamed, Telescoped,
 Natural Development, Open Hole, Other

Top of Lap Pipe or Reduction in Casing
FEET _____ IF TELESCOPED OR MORE THAN ONE SCREEN: USE BACK PAGE

LOG DATA

TYPE OF LOG RUN (Circle One): No Log Run,
Electric, Gamma Ray, Density, Sonic, Neutron,
Other (Describe) _____

Name of Organization Running Log

SCREEN DATA

Diameter - Inches <i>2"</i>	Length - Feet <i>10'</i>	Slot Size - Inches <i>.008</i>
Screen Type <i>PVC</i>	Depth to Bottom - Feet <i>495'</i>	

GEOLOGIC DATA (Office Use Only)

Surface Elev.	Geologic Unit	Unit Thickness	Depth to Top
Subs. SWL	Date	Analysis	Aquifer Test

Driller's Remarks

DESCRIPTION OF FORMATIONS ENCOUNTERED	FROM	TO	FORM	TO
<i>Top soil</i>	<i>0</i>	<i>2</i>		
<i>Red clay</i>	<i>2</i>	<i>10</i>		
<i>Blue mud</i>	<i>10</i>	<i>45</i>		
<i>Coarse sand</i>	<i>45</i>	<i>75</i>		
<i>Blue clay</i>	<i>75</i>	<i>105</i>		
<i>Coarse sand</i>	<i>105</i>	<i>135</i>		
<i>Blue clay</i>	<i>135</i>	<i>225</i>		
<i>Blue clay & sand</i>	<i>225</i>	<i>470</i>		
<i>med. sand</i>	<i>470</i>	<i>490</i>		
<i>Blue clay</i>	<i>490</i>	<i>495</i>		

RECEIVED


OCT 07 1992

Dept. of Environmental Quality
Bureau of Land & Water Resources

IF MORE SPACE IS NEEDED, USE BACK

If well telescopes please
sketch and show depths.

GROUND LEVEL

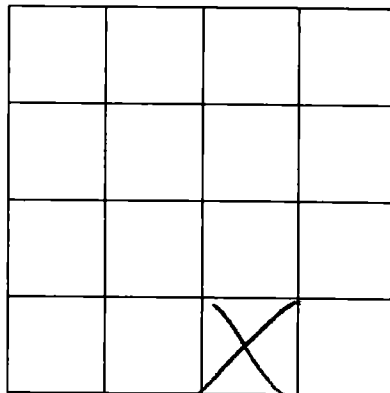

SECTION _____

Please indicate well location X.

ADDITIONAL INFORMATION

If more than one screen,
show location of each on sketch.