

MISSISSIPPI DEPARTMENT OF ENVIRONMENTAL QUALITY
Bureau of Land and Water Resources

P. O. Box 10631
Jackson, MS 39289-0631
WATER WELL DRILLERS LOG

COUNTY WELL LOCATED <i>Jackson</i>	
WELL NUMBER <i>K 7365</i>	CODED
DATE WELL COMPLETED <i>8-21-92</i>	

PERMIT NUMBER
NAME OF DRILLING FIRM <i>Coast Water Well Serv. Inc.</i>

NAME & MAILING ADDRESS OF LANDOWNER <i>Donald Peckinpugh</i>			
WELL LOCATION: SEC <u>8</u> TOWNSHIP <u>N</u> RANGE <u>7</u> <u>E</u>			
DISTANCE <u>1</u> Miles		DIRECTION <u>W</u> of NEAREST TOWN <u>Unalua</u>	
OTHER LANDMARK			
WELL PURPOSE: <input checked="" type="checkbox"/> Home Irrigation, <input type="checkbox"/> Municipal, <input type="checkbox"/> Industrial, <input type="checkbox"/> Fish Pond, etc.			

PUMP DATA		
PUMP TYPE (Circle One): Submersible, Turbine, Jet, Flowing Well, Other (Describe) _____		
POWER TYPE (Circle One): Electric, Tractor, Diesel, Gasoline, Butane, Other (Describe) _____ <u>H/P</u>		
Pump Capacity (GPM)	No. of Stages	Setting Depth _____ FT.
PUMP TEST		
Well yielded _____ GPM with		_____ ft.
a drawdown of _____ ft.		
after _____ hours of pumping		

WELL DATA		
Well Depth <u>307'</u>	Casing Diameter (In.) <u>2"</u>	Casing Length (Ft.) <u>293'</u>
Type of Casing <u>PVC</u>	Hole Depth <u>307'</u>	Depth to Static Water Level <u>70'</u>
TYPE OF COMPLETION: (Circle One or More): <input checked="" type="checkbox"/> Gravel Packed, <input type="checkbox"/> Underreamed, <input type="checkbox"/> Telescoped, <input checked="" type="checkbox"/> Natural Development, <input type="checkbox"/> Open Hole, <input type="checkbox"/> Other		
Top of Lap Pipe or Reduction in Casing _____		
FEET	IF TELESCOPED OR MORE THAN ONE SCREEN: USE BACK PAGE	

LOG DATA	
TYPE OF LOG RUN (Circle One): Electric, Gamma Ray, Density, Sonic, Neutron, Other (Describe) _____ <u>No Log Run</u>	
Name of Organization Running Log _____	

SCREEN DATA		
Diameter - Inches <u>2"</u>	Length - Feet <u>10'</u>	Slot Size - Inches <u>.008</u>
Screen Type <u>PVC</u>	Depth to Bottom - Feet <u>303</u>	

GEOLOGIC DATA (Office Use Only)			
Surface Elev.	Geologic Unit	Unit Thickness	Depth to Top
Subs. SWL	Date	Analysis	Aquifer Test

Driller's Remarks

DESCRIPTION OF FORMATIONS ENCOUNTERED	FROM	TO	FORMAL TESTS	PROVA	TO
<i>Top soil</i>	<i>0</i>	<i>20</i>			
<i>Red/pink sandy clay</i>	<i>2</i>	<i>60</i>			
<i>yellow clay</i>	<i>60</i>	<i>80</i>			
<i>Blue Clay</i>	<i>80</i>	<i>115</i>			
<i>Coarse sand/gravel</i>	<i>115</i>	<i>130</i>			
<i>Blue Clay w/ sand</i>	<i>130</i>	<i>220</i>			
<i>fine sand</i>	<i>220</i>	<i>240</i>			
<i>Blue Clay</i>	<i>240</i>	<i>260</i>			
<i>Coarse sand</i>	<i>260</i>	<i>305</i>			
<i>Blue Clay</i>	<i>305</i>	<i>307</i>			

RECEIVED


OCT 07 1992

Dept. of Environmental Quality
Bureau of Land & Water Resources

IF MORE SPACE IS NEEDED, USE BACK

If well telescopes please sketch and show depths.

GROUND LEVEL

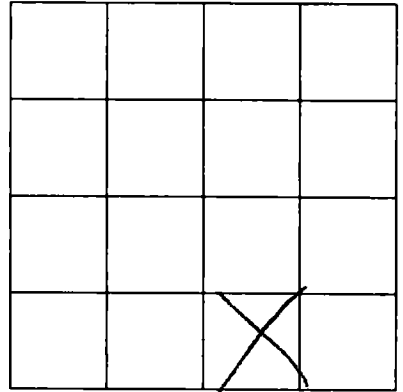

SECTION _____

Please indicate well location X.

• ADDITIONAL INFORMATION

[Faint, illegible text or stamp]

[Faint, illegible text or stamp]

If more than one screen,
show location of each on sketch.