

MISSISSIPPI DEPARTMENT OF ENVIRONMENTAL QUALITY
Bureau of Land and Water Resources

P. O. Box 10631
Jackson, MS 39289-0631
WATER WELL DRILLERS LOG

COUNTY WELL LOCATED <i>Jackson</i>	
WELL NUMBER <i>R2366</i>	CODED
DATE WELL COMPLETED <i>8-20-92</i>	

PERMIT NUMBER
NAME OF DRILLING FIRM <i>Coast Under Well Services, Inc.</i>

NAME & MAILING ADDRESS OF LANDOWNER <i>Hennis Freeman Henry Davis</i>			
WELL LOCATION: SEC <u>32</u> TOWNSHIP <u>6 N</u> RANGE <u>7 E</u>			
DISTANCE <u>3</u> Miles	DIRECTION <u>\$W</u>	NEAREST TOWN <u>Windrove</u>	
OTHER LANDMARK			
WELL PURPOSE: <input checked="" type="checkbox"/> Home, <input type="checkbox"/> Irrigation, <input type="checkbox"/> Municipal, <input type="checkbox"/> Industrial, <input type="checkbox"/> Fish Pond, etc.			

PUMP DATA		
PUMP TYPE (Circle One): Submersible, Turbine, <u>Jet</u> Flowing Well, Other (Describe) _____		
POWER TYPE (Circle One): <u>Electric</u> , Tractor, Diesel, Gasoline, Butane, Other (Describe) _____ H/P <u>1</u>		
Pump Capacity (GPM) <u>6</u>	No. of Stages <u>2</u>	Setting Depth <u> </u> FT.
PUMP TEST Well yielded _____ GPM with a drawdown of _____ ft. after _____ hours of pumping		


WELL DATA		
Well Depth <u>398</u>	Casing Diameter (In.) <u>2"</u>	Casing Length (Ft.) <u>383</u>
Type of Casing <u>PVC</u>	Hole Depth <u>398'</u>	Depth to Static Water Level <u>72'</u>
TYPE OF COMPLETION: (Circle One or More): <u>Gravel Packed</u> , Underreamed, Telescoped, <u>Natural Development</u> , Open Hole, Other (Describe) _____		
Top of Lap Pipe or Reduction in Casing FEET <input type="checkbox"/> IF TELESCOPED OR MORE THAN ONE SCREEN: USE BACK PAGE		

LOG DATA	
TYPE OF LOG RUN (Circle One): Electric, Gamma Ray, Density, Sonic, <u>No Log Run</u> , Other (Describe) _____	
Name of Organization Running Log	

SCREEN DATA		
Diameter - Inches <u>2"</u>	Length - Feet <u>101</u>	Slot Size - Inches <u>.008</u>
Screen Type <u>PVC</u>	Depth to Bottom - Feet <u>393'</u>	

GEOLOGIC DATA (Office Use Only)			
Surface Elev.	Geologic Unit	Unit Thickness	Depth to Top
Subs. SWL	Date	Analysis	Aquifer Test
Driller's Remarks			

DESCRIPTION OF FORMATIONS ENCOUNTERED	FROM	TO
<i>Top soil</i>	<i>0</i>	<i>2</i>
<i>Red (arkite) heavy clay</i>	<i>2</i>	<i>57</i>
<i>Coarse sand</i>	<i>57</i>	<i>75</i>
<i>Blue clay</i>	<i>75</i>	<i>120</i>
<i>fine to coarse sand</i>	<i>120</i>	<i>190</i>
<i>Blue clay</i>	<i>190</i>	<i>325</i>
<i>Blue clay w/ sand</i>	<i>325</i>	<i>350</i>
<i>Gray coarse sand</i>	<i>350</i>	<i>393</i>
<i>Blue clay</i>	<i>393</i>	<i>398</i>

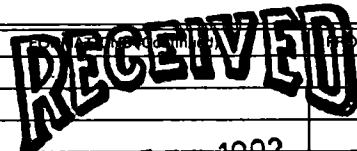


OCT 07 1992

Dept. of Environmental Quality
Bureau of Land & Water Resources

IF MORE SPACE IS NEEDED, USE BACK

If well telescopes please sketch and show depths.

GROUND LEVEL

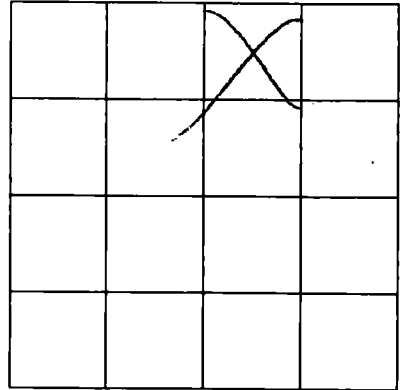

SECTION _____

Please indicate well location X.

ADDITIONAL INFORMATION

If more than one screen,
show location of each on sketch.