

**MISSISSIPPI DEPARTMENT OF ENVIRONMENTAL QUALITY**  
Bureau of Land and Water Resources

P. O. Box 10631  
Jackson, MS 39289-0631  
**WATER WELL DRILLERS LOG**

COUNTY WELL LOCATED <i>Jackson</i>	
WELL NUMBER <i>R 2368</i>	CODED
DATE WELL COMPLETED <i>92</i>	

PERMIT NUMBER
NAME OF DRILLING FIRM <i>Coast Water Well Ser.</i>

NAME & MAILING ADDRESS OF LANDOWNER <i>Glary Summerlin</i>			
WELL LOCATION: SEC <u>33</u> TOWNSHIP <u>6<sup>N</sup> 7<sup>E</sup></u> RANGE			
DISTANCE <u>3</u> Miles <u>S</u> of <u>Van</u> NEAREST TOWN			
OTHER LANDMARK			
WELL PURPOSE: <u>Home</u> , Irrigation, Municipal, Industrial, Fish Pond, etc.			

<b>PUMP DATA</b>		
PUMP TYPE (Circle One): Submersible, Turbine, <u>Jet</u> Flowing Well, Other (Describe)		
POWER TYPE (Circle One): <u>Electric</u> , Tractor, Diesel, Gasoline, Butane, Other (Describe) <u>S/R</u> H/P <u>1</u>		
Pump Capacity (GPM) <u>10</u>	No. of Stages <u>2</u>	Setting Depth <u>        </u> FT.
PUMP TEST		
Well yielded <u>        </u> GPM with a drawdown of <u>        </u> ft. after <u>        </u> hours of pumping		

<b>WELL DATA</b>		
Well Depth <u>655'</u>	Casing Diameter (In.) <u>2"</u>	Casing Length (Ft.) <u>645'</u>
Type of Casing <u>PVC</u>	Hole Depth <u>655'</u>	Depth to Static Water Level
TYPE OF COMPLETION: (Circle One or More): Gravel Packed, Underreamed, Telescoped, <u>Natural Development</u> , Open Hole, Other		
Top of Lap Pipe or Reduction in Casing		
FEET	IF TELESCOPED OR MORE THAN ONE SCREEN: USE BACK PAGE	

<b>LOG DATA</b>	
TYPE OF LOG RUN (Circle One): Electric, Gamma Ray, Density, <u>No Log Run</u> , Sonic, Neutron, Other (Describe)	
Name of Organization Running Log	

<b>SCREEN DATA</b>		
Diameter - Inches <u>2"</u>	Length - Feet <u>15'</u>	Slot Size - Inches <u>.004</u>
Screen Type <u>PVC</u>		Depth to Bottom - Feet <u>655'</u>


<b>GEOLOGIC DATA (Office Use Only)</b>			
Surface Elev.	Geologic Unit	Unit Thickness	Depth to Top
Subs. SWL	Date	Analysis	Aquifer Test
Driller's Remarks			

DESCRIPTION OF FORMATIONS ENCOUNTERED	FROM	TO	FORMATIONS (Continued)	TO
<i>Red clay</i>	<i>0</i>	<i>7</i>	<b>RECEIVED</b>  OCT 07 1992  Dept. of Environmental Quality Bureau of Land & Water Resources	
<i>yellow sandy clay</i>	<i>7</i>	<i>60</i>		
<i>gray clay</i>	<i>60</i>	<i>130</i>		
<i>sand</i>	<i>130</i>	<i>180</i>		
<i>blue clay</i>	<i>180</i>	<i>320</i>		
<i>fine sand</i>	<i>320</i>	<i>335</i>		
<i>blue clay</i>	<i>335</i>	<i>615</i>		
<i>sand</i>	<i>615</i>	<i>655</i>		

IF MORE SPACE IS NEEDED, USE BACK

If well telescopes please sketch and show depths.


GROUND LEVEL

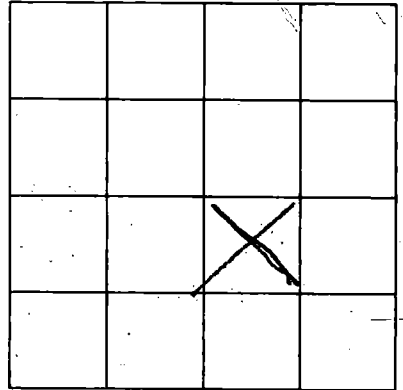

SECTION \_\_\_\_\_

Please indicate well location X.

ADDITIONAL INFORMATION

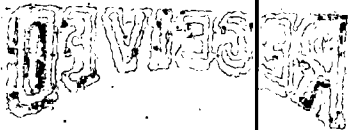

Copyright © 1998 by Environmental Resources International, Inc. All rights reserved.

If more than one screen, show location of each on sketch.