

MISSISSIPPI DEPARTMENT OF ENVIRONMENTAL QUALITY

Office of Land and Water Resources

P. O. Box 10631

Jackson, MS 39289-0631

WATER WELL DRILLERS LOG

COUNTY WELL LOCATED <i>Jackson</i>	
WELL NUMBER <i>K2393</i>	CODED
DATE WELL COMPLETED <i>9-10-93</i>	

PERMIT NUMBER
NAME OF DRILLING FIRM <i>Coastwater Well Service</i>

NAME & MAILING ADDRESS OF LANDOWNER <i>Belinda Carlender</i>		
<i>Tanner Rd</i>		
<i>Vanleave, Ms 39564</i>		
WELL LOCATION: SEC	TOWNSHIP	RANGE
<i>11</i>	<i>6</i>	<i>7</i>
DISTANCE	DIRECTION	NEAREST TOWN
<i>2</i> Miles	<i>EAST</i>	<i>Vanleave</i>
OTHER LANDMARK		
WELL PURPOSE: <input checked="" type="checkbox"/> Home, <input type="checkbox"/> Irrigation, <input type="checkbox"/> Municipal, <input type="checkbox"/> Industrial, <input type="checkbox"/> Fish Pond, etc.		

PUMP DATA		
PUMP TYPE (Circle One): Submersible, Turbine, <input checked="" type="radio"/> Jet, Flowing Well, Other (Describe) _____		
POWER TYPE (Circle One): <input checked="" type="radio"/> Electric, Tractor, Diesel, Gasoline, Butane, Other (Describe) _____ H/P <input checked="" type="checkbox"/>		
Pump Capacity (GPM) <i>8</i>	No. of Stages <i>2</i>	Setting Depth _____ FT.
PUMP TEST		
Well yielded _____ GPM with a drawdown of _____ ft. after _____ hours of pumping		

WELL DATA		
Well Depth <i>150'</i>	Casing Diameter (In.) <i>2"</i>	Casing Length (Ft.) <i>140'</i>
Type of Casing <i>PVC</i>	Hole Depth <i>150'</i>	Depth to Static Water Level <i>55'</i>

LOG DATA	
TYPE OF LOG RUN (Circle One): Electric, Gamma Ray, Density, Sonic, Neutron, Other (Describe) _____ <input checked="" type="checkbox"/> No Log Run	
Name of Organization Running Log	

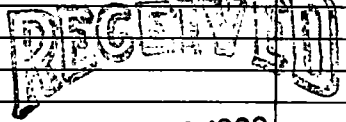
TYPE OF COMPLETION: (Circle One or More):
 Gravel Packed, Underreamed, Telescoped,
 Natural Development, Open Hole, Other
 (Describe) _____

GEOLOGIC DATA (Office Use Only)			
Surface Elev.	Geologic Unit	Unit Thickness	Depth to Top
Subs. SWL	Date	Analysis	Aquifer Test

WELL GROUTED TO A DEPTH OF *20* FEET
 Type Grout (circle one): Cement, Bentonite, or Mix

Driller's Remarks

SCREEN DATA		
Diameter - Inches <i>2"</i>	Length - Feet <i>10'</i>	Slot Size - Inches <i>008</i>
Screen Type <i>PVC</i>	Depth to Bottom - Feet <i>150'</i>	

DESCRIPTION OF FORMATIONS ENCOUNTERED	FROM	TO	FORMATIONS (Continued)	FROM	TO
<i>Top soil</i>	<i>0</i>	<i>2</i>	 OCT 08 1993 Dept. of Environmental Quality Office of Land & Water Resources		
<i>Red clay</i>	<i>2</i>	<i>18</i>			
<i>Red sand</i>	<i>18</i>	<i>35</i>			
<i>Blue clay</i>	<i>35</i>	<i>80</i>			
<i>med. sand</i>	<i>80</i>	<i>150</i>			

IF MORE SPACE IS NEEDED, USE BACK

If well telescopes please sketch and show depths.

GROUND LEVEL

		X	

SECTION //

Please indicate well location X.

ADDITIONAL INFORMATION

If more than one screen,
show location of each on sketch.