

MISSISSIPPI DEPARTMENT OF ENVIRONMENTAL QUALITY

Office of Land and Water Resources

P. O. Box 10631
Jackson, MS 39289-0631
WATER WELL DRILLERS LOG

COUNT WELL LOCATED <i>Jackson</i>	
WELL NUMBER <i>OK 2413</i>	CODING
DATE WELL COMPLETED <i>3-14-94</i>	

PERMIT NUMBER
NAME OF DRILLING FIRM <i>Coast Water Well Dr. Inc.</i>

NAME & MAILING ADDRESS OF LANDOWNER <i>Carl W. Ridgwell, Jr.</i>			
<i>Tanner Rd</i>			
<i>Vandeventer Ms</i>			
WELL LOCATION	SEC	TOWNSHIP	RANGE
	<i>11</i>	<i>6 S</i>	<i>7 W</i>
DISTANCE	DIRECTION	NEAREST TOWN	
<i>2</i> Miles	<i>East</i>	of <i>Vandeventer</i>	
OTHER LANDMARK			
WELL PURPOSE: <input checked="" type="radio"/> Home Irrigation, <input type="radio"/> Municipal, <input type="radio"/> Industrial, <input type="radio"/> Fish Pond, etc.			

PUMP DATA		
PUMP TYPE (Circle One): Submersible, Turbine, <input checked="" type="radio"/> Flowing Well , Other (Describe) _____		
POWER TYPE (Circle One): <input checked="" type="radio"/> Electric , Tractor, Diesel, Gasoline, Butane, Other (Describe) _____ H/P <i>1</i>		
Pump Capacity (GPM) <i>8</i>	No. of Stages <i>2</i>	Setting Depth _____ FT.
PUMP TEST		
Well yielded _____ GPM with a drawdown of _____ ft. after _____ hours of pumping		

WELL DATA		
Well Depth <i>140'</i>	Casing Diameter (In) <i>2"</i>	Casing Length (Ft.) <i>130'</i>
Type of Casing <i>PVC</i>	Hole Depth <i>140'</i>	Depth to Static Water Level <i>50'</i>
TYPE OF COMPLETION: (Circle One or More): <input checked="" type="radio"/> Natural Development , <input type="radio"/> Gravel Packed, <input type="radio"/> Underreamed, <input type="radio"/> Telescoped, <input type="radio"/> Open Hole, <input type="radio"/> Other (Describe) _____		
WELL GROUTED TO A DEPTH OF <i>20</i> FEET Type Grout (circle one): Cement, <input checked="" type="radio"/> Bentonite , or Mix		

LOG DATA	
TYPE OF LOG RUN (Circle One): <input checked="" type="radio"/> No Log Run , Electric, Gamma Ray, Density, Sonic, Neutron, Other (Describe) _____	
Name of Organization Running Log	

SCREEN DATA		
Diameter - Inches <i>2"</i>	Length - Feet <i>10'</i>	Slot Size - Inches <i>.004</i>
Screen Type <i>PVC</i>	Depth to Bottom - Feet <i>140'</i>	


GEOLOGIC DATA (Office Use Only)			
Surface Elev.	Geologic Unit	Unit Thickness	Depth to Top
Subs SWL	Date	Analysis	Aquifer Test
Driller's Remarks			
Top of Lap Pipe or Reduction in Casing			
FEET		IF TELESCOPED OR MORE THAN ONE SCREEN: USE BACK PAGE	

DESCRIPTION OF FORMATIONS ENCOUNTERED	FROM	TO
<i>Top soil</i>	<i>0</i>	<i>2</i>
<i>Yellow gray clay</i>	<i>2</i>	<i>18</i>
<i>Blue clay</i>	<i>18</i>	<i>30</i>
<i>Blue clay</i>	<i>30</i>	<i>60</i>
<i>fine sand</i>	<i>60</i>	<i>80</i>
<i>Coarse to med sand</i>	<i>80</i>	<i>140</i>

FORMATIONS (Continued)	FROM	TO
RECEIVED		
APR 07 1994		
Dept of Environmental Quality Office of Land & Water Resources		
IF MORE SPACE IS NEEDED, USE BACK		

If well telescopes please sketch and show depths.

GROUND LEVEL

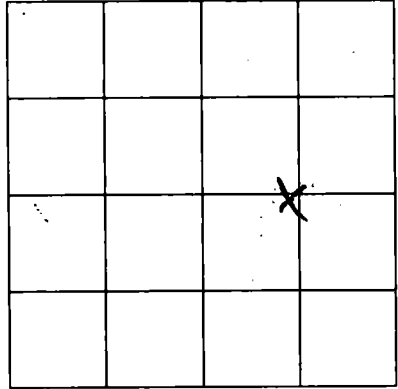

SECTION 11

Please indicate well location X.

ADDITIONAL INFORMATION

RECEIVED

DEC 11 1964

If more than one screen,
show location of each on sketch.