

**MISSISSIPPI DEPARTMENT OF ENVIRONMENTAL QUALITY**

Office of Land and Water Resources

P. O. Box 10631  
Jackson, MS 39289-0631  
**WATER WELL DRILLERS LOG**

COUNTY WELL LOCATED <i>Jackson</i>	
WELL NUMBER <i>R 2014</i>	CODED
DATE WELL COMPLETED <i>3-15-94</i>	

PERMIT NUMBER
NAME OF DRILLING FIRM <i>Coastal Water Well Drilling</i>

NAME & MAILING ADDRESS OF LANDOWNER <i>L.L. Durant</i> <i>Johns Bayou Church</i> <i>Handlone, Ms.</i>			
WELL LOCATION	SEC	TOWNSHIP	RANGE
	<i>25</i>	<i>6 N</i>	<i>7 W</i>
DISTANCE	DIRECTION	NEAREST TOWN	
<i>4</i> Miles	<i>SE</i>	of <i>Varccave</i>	
OTHER LANDMARK			
WELL PURPOSE <i>Camp</i> Irrigation, Municipal, Industrial, Fish Pond, etc			

PUMP DATA			
PUMP TYPE (Circle One): <u>Submersible</u> , Turbine, Jet, Flowing Well, Other (Describe) _____			
POWER TYPE (Circle One): <u>Electric</u> , Tractor, Diesel, Gasoline, Butane, Other (Describe) _____ H/P <i>1/2</i>			
Pump Capacity (GPM) <i>10</i>	No. of Stages <i>6</i>	Setting Depth _____ FT.	
PUMP TEST			
Well yielded _____ GPM with a drawdown of _____ ft. after _____ hours of pumping			

WELL DATA		
Well Depth <i>110'</i>	Casing Diameter (In) <i>4"</i>	Casing Length (Ft.) <i>100'</i>
Type of Casing <i>PVC</i>	Hole Depth <i>110'</i>	Depth to Static Water Level <i>ground level</i>
TYPE OF COMPLETION: (Circle One or More): <u>Natural Development</u> , Gravel Packed, Underreamed, Telescoped, Open Hole, Other (Describe) _____		

LOG DATA			
TYPE OF LOG RUN (Circle One): <u>No Log Run</u> , Electric, Gamma Ray, Density, Sonic, Neutron, Other (Describe) _____			
Name of Organization Running Log			

WELL GROUTED TO A DEPTH OF <i>20</i> FEET
Type Grout (circle one): Cement, <u>Bentonite</u> , or Mix

GEOLOGIC DATA (Office Use Only)			
Surface Elev.	Geologic Unit	Unit Thickness	Depth to Top
Subs SWL	Date	Analysis	Aquifer Test

SCREEN DATA		
Diameter - Inches <i>4"</i>	Length - Feet <i>10</i>	Slot Size - Inches <i>.008</i>
Screen Type <i>PVC</i>	Depth to Bottom - Feet <i>110'</i>	


Driller's Remarks			
Top of Lap Pipe or Reduction in Casing			
FEET <input type="checkbox"/> TELESCOPED OR MORE THAN ONE SCREEN: USE BACK PAGE			

DESCRIPTION OF FORMATIONS ENCOUNTERED	FROM	TO
<i>top soil</i>	<i>0</i>	<i>2</i>
<i>yellow gray clay</i>	<i>2</i>	<i>12</i>
<i>med. sand</i>	<i>12</i>	<i>25</i>
<i>blue clay</i>	<i>25</i>	<i>60</i>
<i>med sand</i>	<i>60</i>	<i>110</i>

FORMATIONS (Continued)	FROM	TO
<b>RECEIVED</b>		
<b>APR 07 1994</b>		
Dept. of Environmental Quality Office of Land & Water Resources		
IF MORE SPACE IS NEEDED, USE BACK		

If well telescopes please sketch and show depths.

GROUND LEVEL

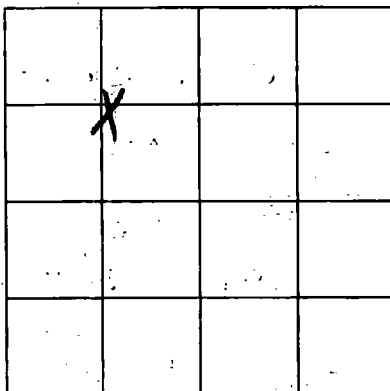

SECTION 25

Please indicate well location X.

ADDITIONAL INFORMATION

Multiple horizontal lines for additional information.

REVIEWED  
DATE: 10/10/2014  
WELL COMPLETION LOG  
WELL NO. 10-10-14

If more than one screen, show location of each on sketch.