

MISSISSIPPI DEPARTMENT OF ENVIRONMENTAL QUALITY

Office of Land and Water Resources

P. O. Box 10631
Jackson, MS 39289-0631
WATER WELL DRILLERS LOG

COUNTY WELL LOCATED Jackson	
WELL NUMBER K 2419	CODED
DATE WELL COMPLETED 4-18-94	

PERMIT NUMBER
NAME OF DRILLING FIRM Coast Water Well Service, Inc.

NAME & MAILING ADDRESS OF LANDOWNER Calvin Dollar			
7th. Pleasant Rd.			
Vance, Ms.			
WELL LOCATION	SEC	TOWNSHIP	RANGE
SE	2	6th	7th
DISTANCE	DIRECTION	NEAREST TOWN	
2 Miles	NE	of Vance	
OTHER LANDMARK			
WELL PURPOSE <input checked="" type="checkbox"/> Home <input type="checkbox"/> Irrigation, Municipal, Industrial, Fish Pond, etc.			

PUMP DATA		
PUMP TYPE (Circle One): Submersible, Turbine, Jet, Flowing Well, Other (Describe) _____		
POWER TYPE (Circle One): Electric, Tractor, Diesel, Gasoline, Butane, Other (Describe) _____ H/P _____		
Pump Capacity (GPM)	No. of Stages	Setting Depth _____ FT.
PUMP TEST		
Well yielded _____ GPM with		_____ ft.
a drawdown of _____ ft.		
after _____ hours of pumping		

WELL DATA		
Well Depth 534'	Casing Diameter (In.) 2"	Casing Length (Ft.) 523'
Type of Casing PVC	Hole Depth 537'	Depth to Static Water Level 105'
TYPE OF COMPLETION: (Circle One or More): <input checked="" type="checkbox"/> Gravel Packed <input type="checkbox"/> Underreamed, <input type="checkbox"/> Telescoped, <input checked="" type="checkbox"/> Natural Development. <input type="checkbox"/> Open Hole. <input type="checkbox"/> Other (Describe) _____		

LOG DATA	
TYPE OF LOG RUN (Circle One): <input checked="" type="checkbox"/> No Log Run, <input type="checkbox"/> Electric, <input type="checkbox"/> Gamma Ray, <input type="checkbox"/> Density, <input type="checkbox"/> Sonic, <input type="checkbox"/> Neutron, <input type="checkbox"/> Other (Describe) _____	
Name of Organization Running Log	

WELL GROUTED TO A DEPTH OF 20 FEET
Type Grout (circle one): Cement <input checked="" type="checkbox"/> Bentonite <input type="checkbox"/> or Mix

GEOLOGIC DATA (Office Use Only)			
Surface Elev.	Geologic Unit	Unit Thickness	Depth to Top
Subs. SWL	Date	Analysis	Aquifer Test

SCREEN DATA		
Diameter - Inches 2"	Length - Feet 10'	Slot Size - Inches .008
Screen Type PVC	Depth to Bottom - Feet 537'	


Driller's Remarks	
Top of Lap Pipe or Reduction in Casing	
FEET	IF TELESCOPED OR MORE THAN ONE SCREEN: USE BACK PAGE

DESCRIPTION OF FORMATIONS ENCOUNTERED	FROM	TO
Top Soil	0	2
Red Clay	2	45
Medium Sand	45	70
Yellow Clay	70	125
Medium Sand	125	150
Blue Clay streaks of sand	150	410
Fine Sand	410	420
Blue Clay streaks of sand	420	485
Blue Clay	485	518
Coarse sand	518	534
Blue Clay	534	537

FORMATIONS (Continued)	FROM	TO
RECEIVED		
MAY 09 1994		
Dept. of Environmental Quality Office of Land & Water Resources		
IF MORE SPACE IS NEEDED, USE BACK		

If well telescopes please sketch and show depths.

GROUND LEVEL

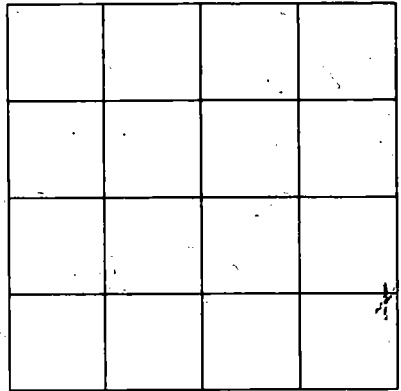

SECTION 2

Please indicate well location X.

ADDITIONAL INFORMATION

REGISTERED

1991

ENVIRONMENTAL PROTECTION AGENCY
WASHINGTON, DC 20460

If more than one screen,
show location of each on sketch.