

MISSISSIPPI DEPARTMENT OF ENVIRONMENTAL QUALITY

Office of Land and Water Resources

P. O. Box 10631
Jackson, MS 39289-0631
WATER WELL DRILLERS LOG

COUNTY WELL LOCATED Jackson	
WELL NUMBER JK 2423	CODED
DATE WELL COMPLETED 5-27-94	

PERMIT NUMBER
NAME OF DRILLING FIRM Coast Water Well Service, Inc.

NAME & MAILING ADDRESS OF LANDOWNER Quint Moran Tanner Rd Vandeventer, Ms			
WELL LOCATION	SEC	TOWNSHIP	RANGE
	11	6	7E
DISTANCE	DIRECTION	NEAREST TOWN	
2 Miles	East	of Vandeventer	
OTHER LANDMARK			
WELL PURPOSE <input checked="" type="checkbox"/> Home, <input type="checkbox"/> Irrigation, <input type="checkbox"/> Municipal, <input type="checkbox"/> Industrial, <input type="checkbox"/> Fish Pond, etc.			

PUMP DATA		
PUMP TYPE (Circle One): Submersible, Turbine, <input checked="" type="checkbox"/> Jet , Flowing Well, Other (Describe) _____		
POWER TYPE (Circle One): <input checked="" type="checkbox"/> Electric , Tractor, Diesel, Gasoline, Butane, Other (Describe) _____ H/P 1		
Pump Capacity (GPM) 9	No. of Stages 2	Setting Depth _____ FT.
PUMP TEST Well yielded _____ GPM with a drawdown of _____ ft. after _____ hours of pumping		

WELL DATA		
Well Depth 150'	Casing Diameter (In) 2"	Casing Length (Ft.) 150'
Type of Casing PVC	Hole Depth 150'	Depth to Static Water Level 60'
TYPE OF COMPLETION: (Circle One or More): <input checked="" type="checkbox"/> Gravel Packed, <input type="checkbox"/> Underreamed, <input type="checkbox"/> Telescoped, <input checked="" type="checkbox"/> Natural Development, <input type="checkbox"/> Open Hole, <input type="checkbox"/> Other (Describe) _____		

LOG DATA	
TYPE OF LOG RUN (Circle One): Electric, Gamma Ray, Density, Sonic, Neutron, <input checked="" type="checkbox"/> No Log Run , Other (Describe) _____	
Name of Organization Running Log	

WELL GROUTED TO A DEPTH OF 20 FEET Type Grout (circle one): Cement, <input checked="" type="checkbox"/> Bentonite , or Mix

GEOLOGIC DATA (Office Use Only)			
Surface Elev.	Geologic Unit	Unit Thickness	Depth to Top
Subs. SWL	Date	Analysis	Aquifer Test
Driller's Remarks			
Top of Lap Pipe or Reduction in Casing FEET IF TELESCOPED OR MORE THAN ONE SCREEN: USE BACK PAGE			


SCREEN DATA		
Diameter - Inches 2"	Length - Feet 10'	Slot Size - Inches 004
Screen Type PVC	Depth to Bottom - Feet 150'	

DESCRIPTION OF FORMATIONS ENCOUNTERED	FROM	TO
Top Soil	0	2
Orange Clay	2	15
Gray + Blue Clay	15	70
Fine to Coarse Sand	70	150

FORMATIONS (Continued)	FROM	TO
RECEIVED		
JUN 03 1994		
Dept. of Environmental Quality Office of Land & Water Resources		
IF MORE SPACE IS NEEDED, USE BACK		

If well telescopes please sketch and show depths.

GROUND LEVEL

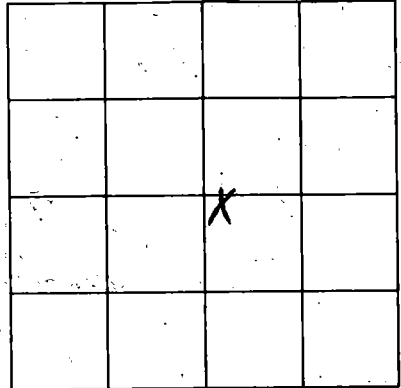

SECTION 11

Please indicate well location X.

ADDITIONAL INFORMATION

Lined area for additional information.

RECEIVED
MAY 19 1968

OFFICE OF THE
STATE ENGINEER

STATE OF CALIFORNIA
DIVISION OF WATER RESOURCES

If more than one screen,
show location of each on sketch.