

MISSISSIPPI DEPARTMENT OF ENVIRONMENTAL QUALITY

Office of Land and Water Resources

P. O. Box 10631
Jackson, MS 39289-0631
WATER WELL DRILLERS LOG

COUNTY WELL LOCATED <i>Jackson</i>	
WELL NUMBER <i>K 2431</i>	CODED
DATE WELL COMPLETED <i>8-9-94</i>	

PERMIT NUMBER
NAME OF DRILLING FIRM <i>Coastal Water Well Service</i>

NAME & MAILING ADDRESS OF LANDOWNER <i>Lettie Fairley</i>			
<i>Hwy 57</i>			
<i>Vanceleave</i>			
WELL LOCATION	SEC	TOWNSHIP	RANGE
	<i>4</i>	<i>6 N S</i>	<i>7 E W</i>
DISTANCE	DIRECTION	NEAREST TOWN	
<i>1</i> Miles	<i>N</i>	<i>Vanceleave</i>	
OTHER LANDMARK			
WELL PURPOSE <input checked="" type="radio"/> Home, <input type="radio"/> Irrigation, <input type="radio"/> Municipal, <input type="radio"/> Industrial, <input type="radio"/> Fish Pond, etc			

PUMP DATA		
PUMP TYPE (Circle One): Submersible, Turbine, <input checked="" type="radio"/> Jet, <input type="radio"/> Flowing Well, Other (Describe) _____		
POWER TYPE (Circle One): <input checked="" type="radio"/> Electric, <input type="radio"/> Tractor, <input type="radio"/> Diesel, <input type="radio"/> Gasoline, <input type="radio"/> Butane, Other (Describe) _____ H/P <i>1</i>		
Pump Capacity (GPM) <i>5</i>	No. of Stages <i>2</i>	Setting Depth _____ FT.
PUMP TEST		
Well yielded _____ GPM with a drawdown of _____ ft. after _____ hours of pumping		

WELL DATA		
Well Depth <i>280</i>	Casing Diameter (In.) <i>8"</i>	Casing Length (Ft.) <i>270</i>
Type of Casing <i>PVC</i>	Hole Depth <i>280'</i>	Depth to Static Water Level <i>72'</i>
TYPE OF COMPLETION: (Circle One or More): <input checked="" type="radio"/> Gravel Packed, <input type="radio"/> Underreamed, <input type="radio"/> Telescoped, <input checked="" type="radio"/> Natural Development, <input type="radio"/> Open Hole, <input type="radio"/> Other (Describe) _____		
WELL GROUTED TO A DEPTH OF <i>20</i> FEET Type Grout (circle one): <input checked="" type="radio"/> Cement, <input type="radio"/> Bentonite, or Mix		

LOG DATA	
TYPE OF LOG RUN (Circle One): <input checked="" type="radio"/> No Log Run, <input type="radio"/> Electric, <input type="radio"/> Gamma Ray, <input type="radio"/> Density, <input type="radio"/> Sonic, <input type="radio"/> Neutron, Other (Describe) _____	
Name of Organization Running Log	

SCREEN DATA		
Diameter - Inches <i>2"</i>	Length - Feet <i>10'</i>	Slot Size - Inches <i>.008"</i>
Screen Type <i>PVC</i>	Depth to Bottom - Feet <i>280'</i>	


GEOLOGIC DATA (Office Use Only)			
Surface Elev.	Geologic Unit	Unit Thickness	Depth to Top
Subs SWL	Date	Analysis	Aquifer Test
Driller's Remarks			
Top of Lap Pipe or Reduction in Casing			
FEET		IF TELESCOPED OR MORE THAN ONE SCREEN: USE BACK PAGE	

DESCRIPTION OF FORMATIONS ENCOUNTERED	FROM	TO	FORMATIONS (Continued)	FROM	TO
<i>Top Soil</i>	<i>0</i>	<i>2</i>	RECEIVED SEP 21 1994 Dept. of Environmental Quality Office of Land & Water Resources		
<i>Crack Blue-gray Clay</i>	<i>2</i>	<i>50</i>			
<i>fine-grained sand</i>	<i>50</i>	<i>110</i>			
<i>Blue-gray streaked sand</i>	<i>110</i>	<i>250</i>			
<i>Coarse sand</i>	<i>250</i>	<i>280</i>			

IF MORE SPACE IS NEEDED USE BACK

If well telescopes please sketch and show depths.

GROUND LEVEL

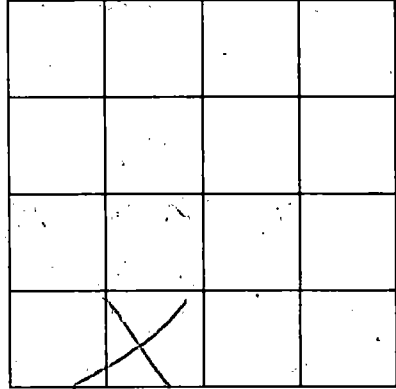

SECTION 4

Please indicate well location X.

ADDITIONAL INFORMATION

RESERVED

2001 11 22

RESERVED TO THE
BUREAU OF LAND & WATER

If more than one screen,
show location of each on sketch.